


FINISH CHART	
IDEN	TYPE
WD-02	STAIN



THE ART OF BRINGING STORIES TO LIFE.

**Released:**

NO:	0	07/05/2017	INITIAL SUBMISSION	DC	SCH	WH	XX	XX	XX
Date:	08/04/2017	REVISE PER CUSTOMER REQUEST	DC	MT	XX	XX	XX	XX	XX

Revisions: Drawn By: Review By: PM

**Client Approval**

Signature: \_\_\_\_\_ Date: \_\_\_\_\_

☒ Review & Return ☐ For Information Only

☐ Approved ☐ Approved As Noted ☐ Revise And Resubmit

**PROJECT MANAGER**  
WHITNEY HINES

**CONTACT INFORMATION**  
whitney.hines@solomongroup.com

**STANDARD TOLERANCES**  
DIMENSIONS IN INCHES  
FRACTIONS DECIMALS  
1/8" 0.125" 1/16" 0.0625"  
1/4" 0.250" 1/8" 0.125"  
3/8" 0.375" 1/4" 0.250"  
1/2" 0.500" 3/8" 0.375"  
3/4" 0.750" 1/2" 0.500"  
1" 1.000" 3/4" 0.750"  
1 1/8" 1.125" 1" 1.000"


**PROJECT NAME**  
BE WASHINGTON

**PROJECT ADDRESS**  
3200 MOUNT VERNON HWY, MT VERNON, VA 22121

**SG JOB #**  
6020

**SHEET TITLE**  
PODIUM OVERVIEW

**X.03.408**

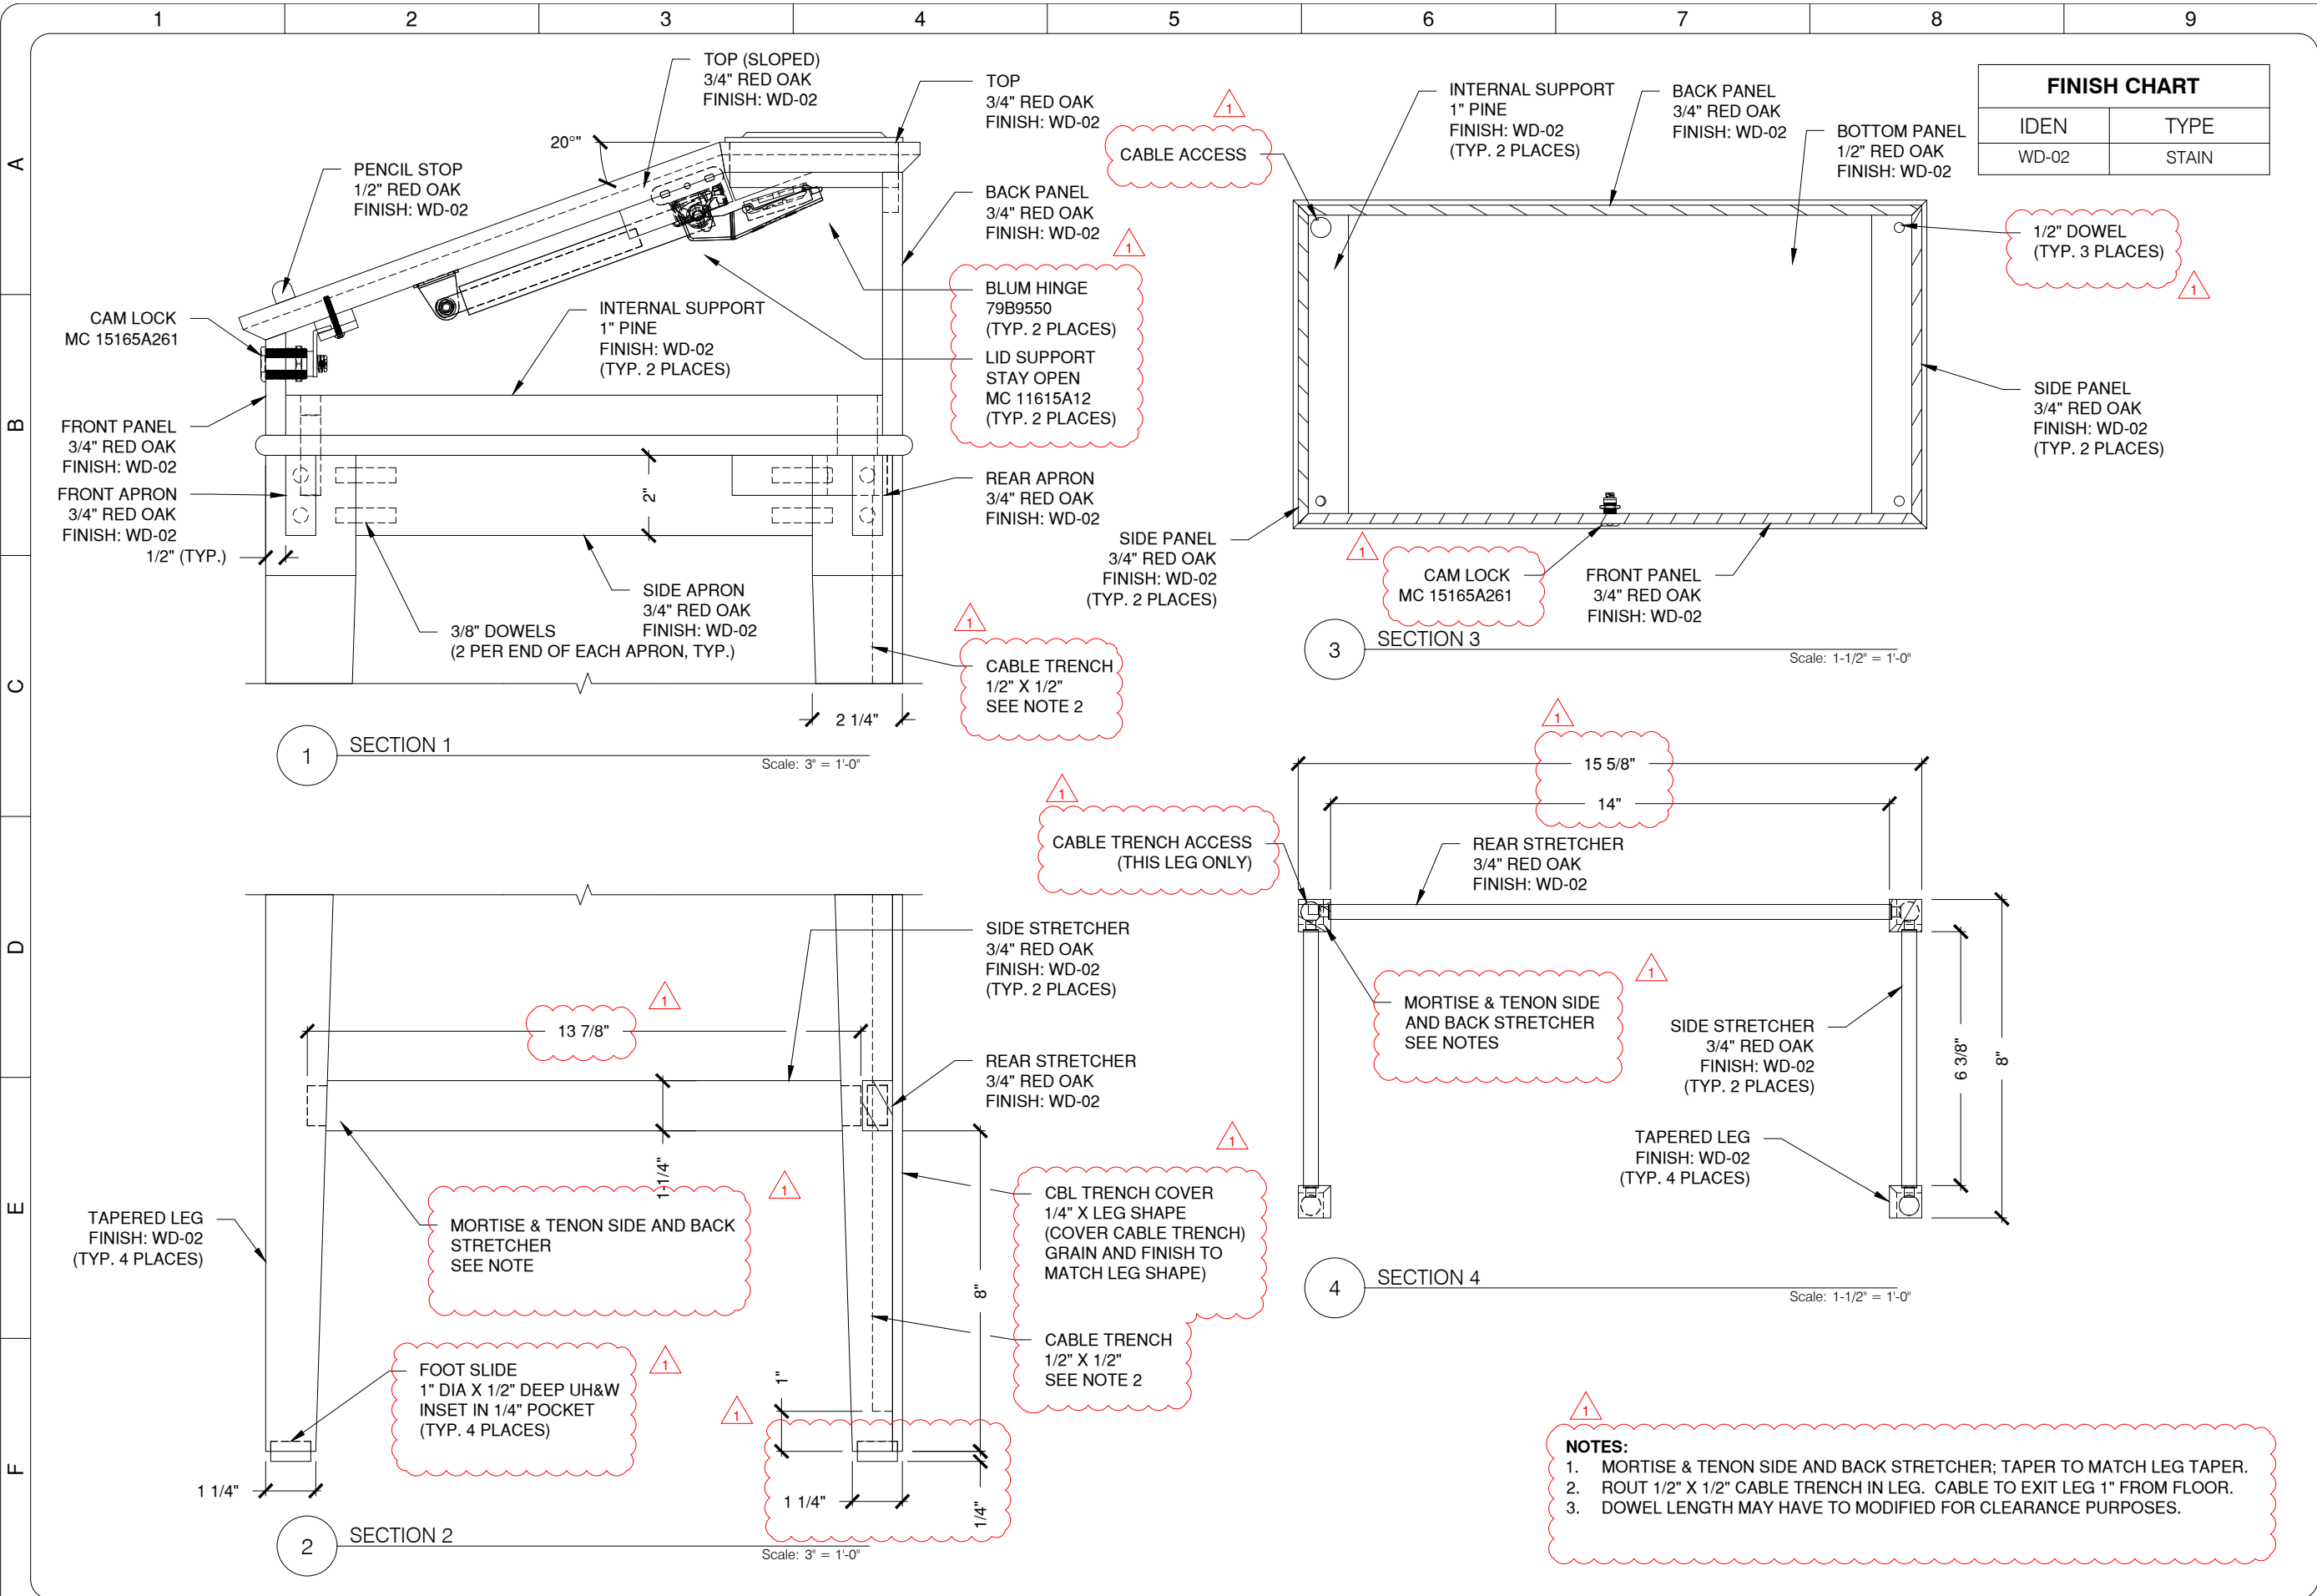

FINISH CHART	
IDEN	TYPE
WD-02	STAIN

THE ART OF BRINGING STORIES TO LIFE.

**Released:**

NO:	0	1	2	3	4
Date:	07/05/2017	08/04/2017			
Revisions:	INITIAL SUBMISSION	REVISE PER CUSTOMER REQUEST			
Drawn By:	DC	DC			
Review By:	WH	MT			
PM	WH	XX			

**Client Approval**

Signature: \_\_\_\_\_ Date: \_\_\_\_\_

☒ Review & Return    ☐ For Information Only

☐ Approved    ☐ Approved As Noted    ☐ Revise And Resubmit

**PROJECT MANAGER**  
WHITNEY HINES

**CONTACT INFORMATION**  
whitney.hines@solomongroup.com

**STANDARD TOLERANCES**  
DIMENSION FINISH  
XX 1/16" ± 1/32"  
XX 1/8" ± 1/16"  
XX 1/4" ± 1/8"  
XX 3/8" ± 1/16"  
XX 1/2" ± 1/8"  
XX 3/4" ± 1/8"  
XX 1" ± 1/8"  
XX 1 1/4" ± 1/8"  
XX 1 1/2" ± 1/8"  
XX 1 3/4" ± 1/8"  
XX 2" ± 1/8"


**PROJECT NAME**  
BE WASHINGTON

**PROJECT ADDRESS**  
3200 MOUNT VERNON HWY., MT VERNON, VA 22121

**SHEET TITLE**  
PODIUM SECTIONS

**SG JOB #**  
6020


**X.03.409**

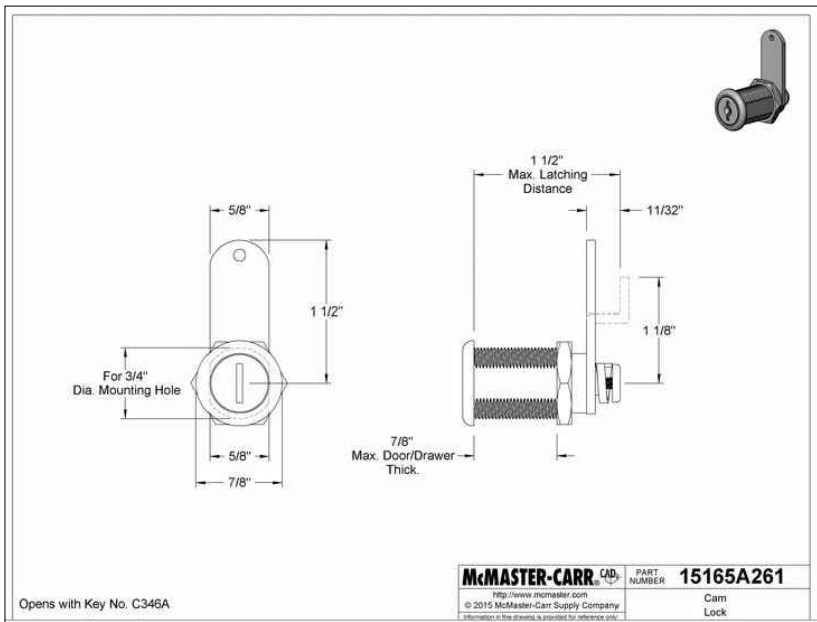

Scale: NTS

Scale: NTS

Scale: NTS

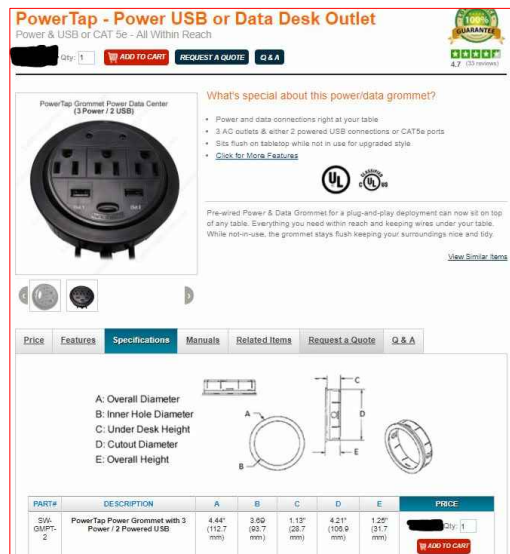

Scale: NTS