

solomongroup  
THE ART OF BRINGING STORIES TO LIFE.

**Released:**

NO:	Date	Revisions:	Drawn By	Review By	PM	WH	MT	XX	XX
0	06/28/2017	Initial Submission	SCHR	NL					
1	7/11/2017	REVISION 1	SCHR	MT					
2									
3									
4									

**Client Approval**

Signature: \_\_\_\_\_ Date: \_\_\_\_\_

☒ Review & Return

☐ Approved

☐ Approved As Noted

☐ Revise And Resubmit

**PROJECT MANAGER**  
Whitney Hines

**CONTACT INFORMATION**  
whitney.hines@solomongroup.com

**STANDARD TOLERANCES**  
DIMENSIONS IN INCHES  
FRACTIONS DECIMALS  
1/16" 0.0625"  
1/8" 0.125"  
3/16" 0.1875"  
1/4" 0.25"  
3/8" 0.375"  
1/2" 0.5"  
3/4" 0.75"  
1" 1.0"  
2" 2.0"  
4" 4.0"  
6" 6.0"  
100" 100.0"

**PROJECT NAME**  
Be Washington


**PROJECT ADDRESS**  
3200 MOUNT VERNON HWY, MT VERNON, VA 22121

**SHEET TITLE**  
Station Kiosk Overview

**SG JOB #**  
6020

**Z.03.401**

DISCLAIMER: SOLOMON GROUP MAKES NO REPRESENTATION OR WARRANTIES, EXPRESS OR IMPLIED, WITH RESPECT TO THE USE OF THE DRAWING PROVIDED HEREIN, REGARDLESS OF ITS FORMAT OR THE MEANS OF ITS TRANSMISSION. THERE IS NO GUARANTEE OR REPRESENTATION TO THE USER AS TO THE ACCURACY, CURRENCY, SUITABILITY, OR RELIABILITY OF THIS DRAWING FOR ANY PURPOSE. THIS DRAWING AND INFORMATION CONTAINED HEREIN IS FOR GENERAL PRESENTATION PURPOSES ONLY. THE DRAWING IS NOT INTENDED FOR USE ON ENGINEERING DESIGN PLANS. THIS DRAWING AND THE INFORMATION CONTAINED THEREIN IS THE CONFIDENTIAL, PROPRIETARY INFORMATION OF SOLOMON GROUP AND MAY NOT BE USED OR REPRODUCED WITHOUT APPROVAL OF SOLOMON GROUP. COPYRIGHT SOLOMON GROUP 2017. ALL RIGHTS RESERVED.

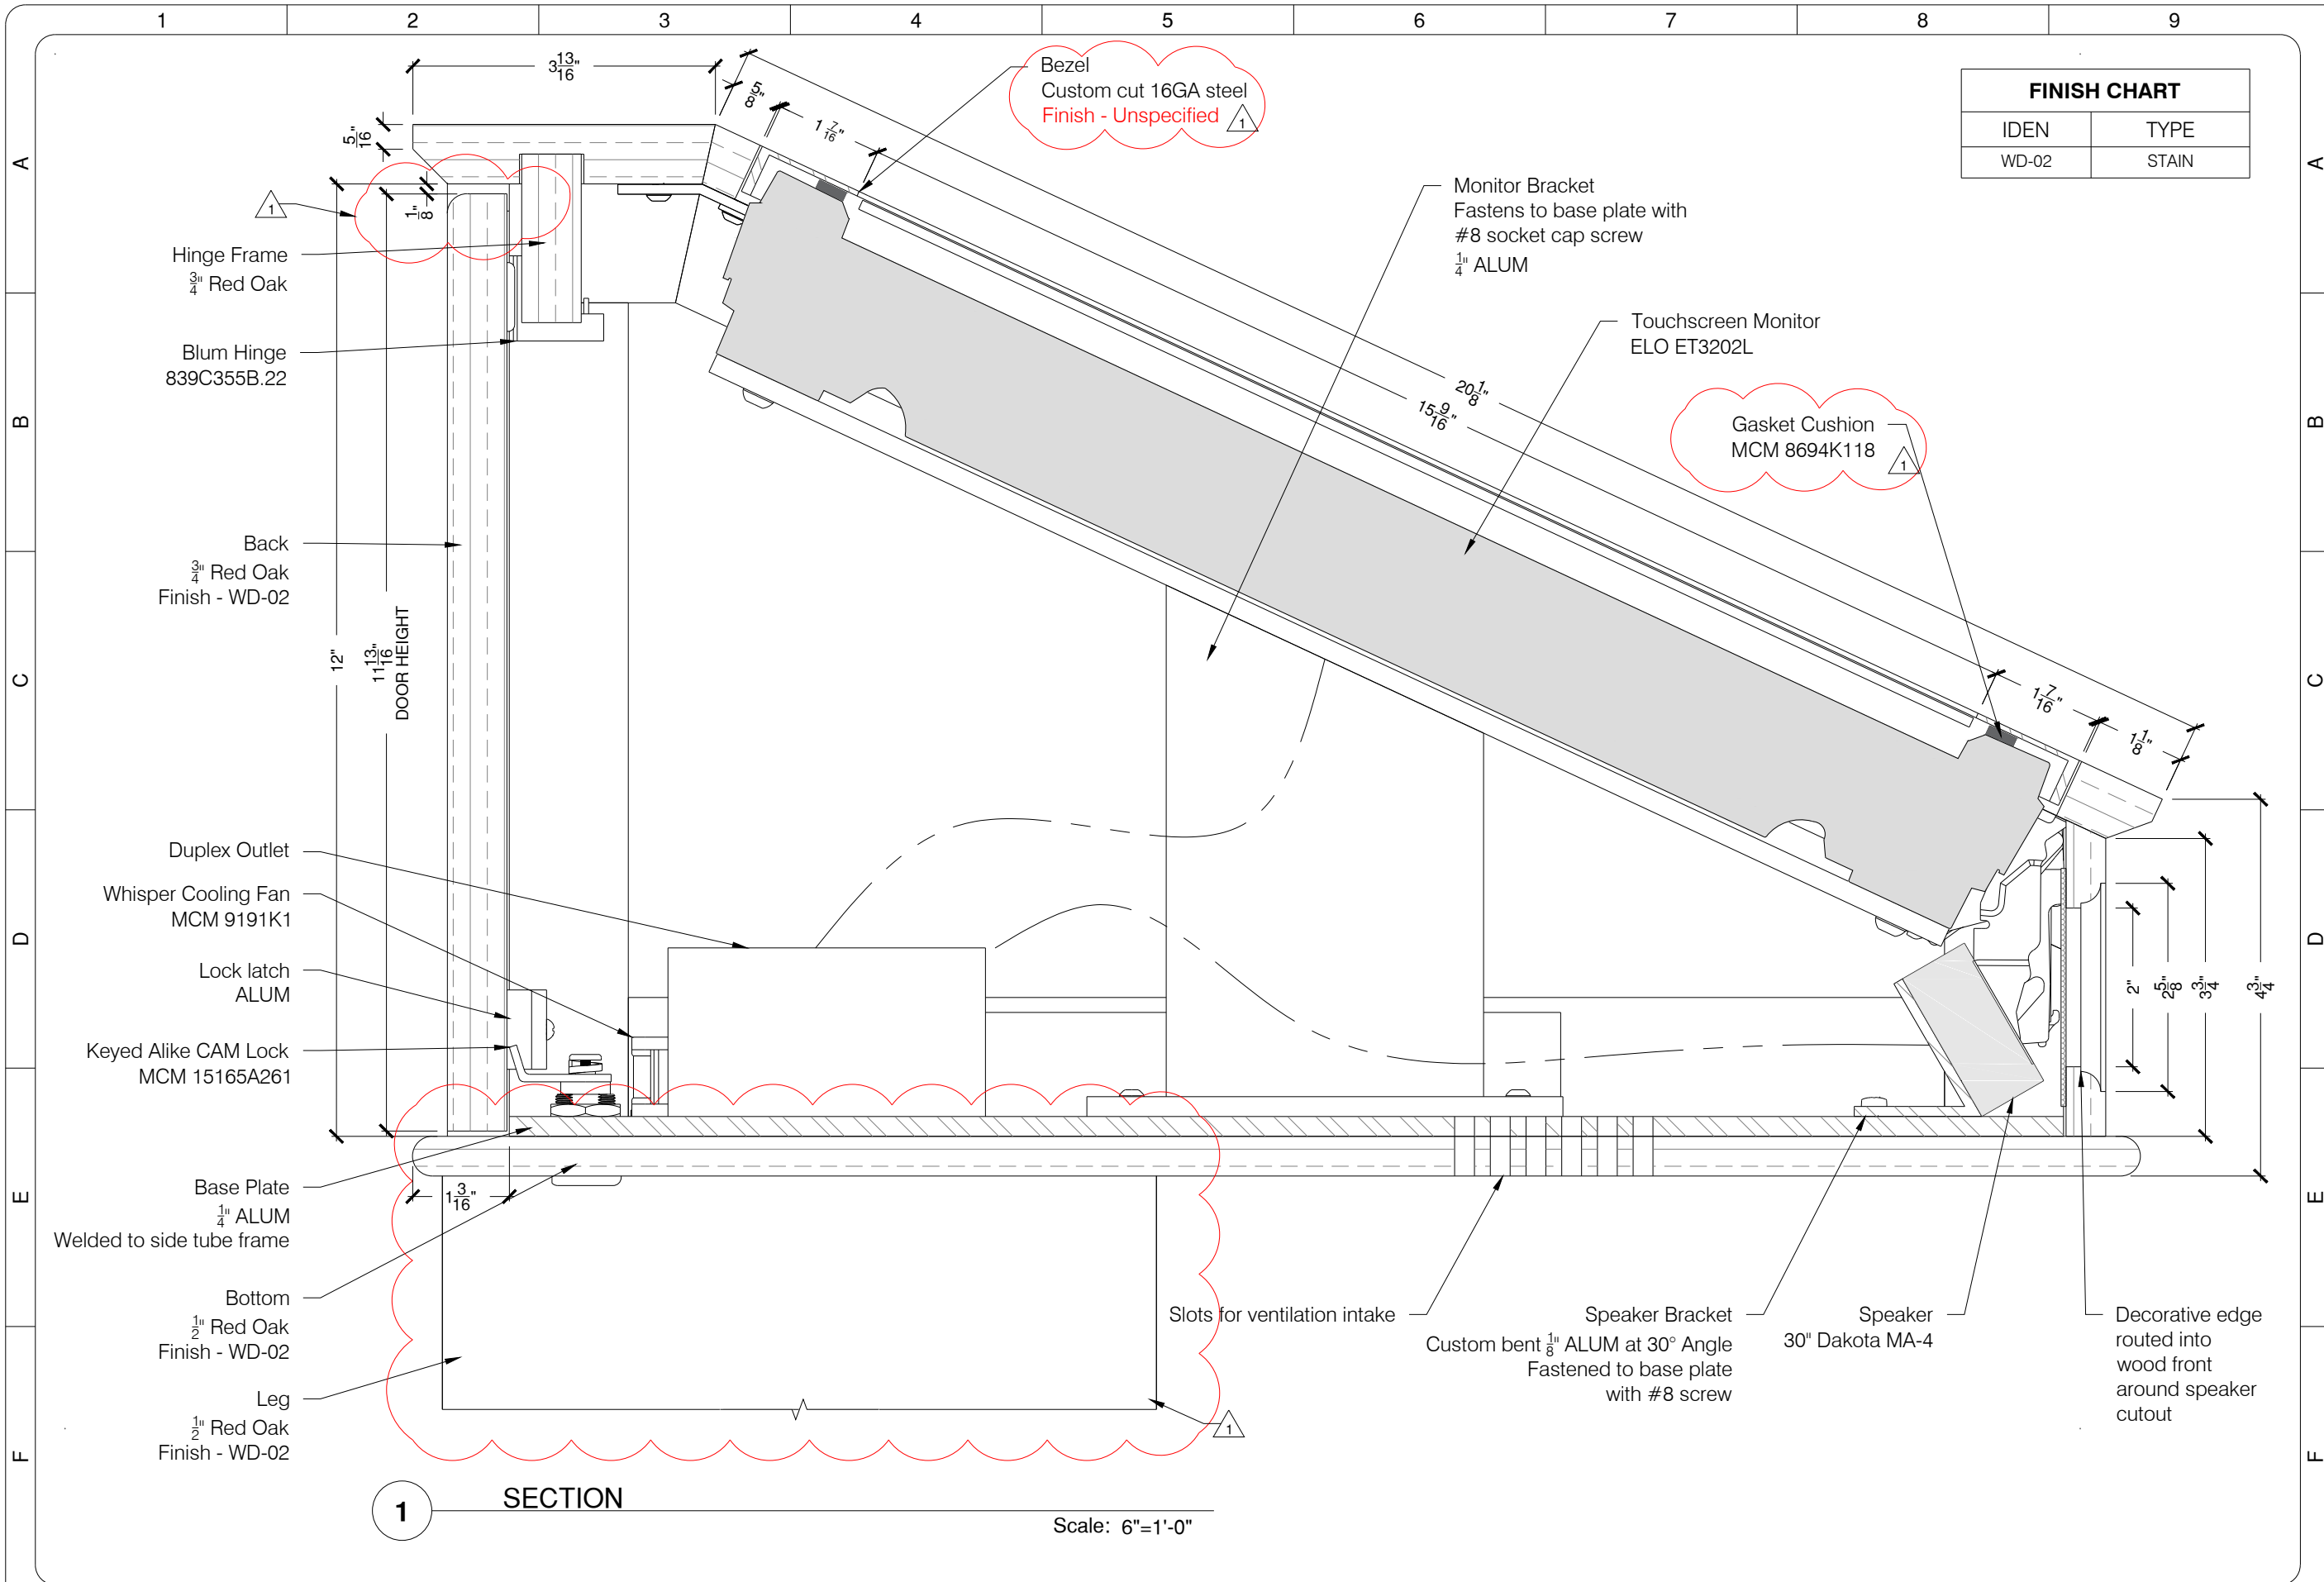

Released:		PM	WH	XX
NO:	Date	Revisions:	Drawn By	Review By
0	06/26/2017	Initial Submission	SCHR	NL
1	7/11/2017	REVISION 1	SCHR	MT
2				XX
3				XX
4				XX

Client Approval

Signature: \_\_\_\_\_ Date: \_\_\_\_\_

Review & Return ☒ For Information Only ☐ Approved ☐ Approved As Noted ☐ Revise And Resubmit

PROJECT NAME  
Be Washington

PROJECT ADDRESS  
3200 MOUNT VERNON HWY, MT VERNON, VA 22121

PROJECT MANAGER  
Whitney Hines


CONTACT INFORMATION  
whitney.hines@solomongroup.com

SHEET TITLE  
Station Kiosk Section 1

SG JOB #  
6020

Z.03.402

DISCLAIMER: SOLOMON GROUP MAKES NO REPRESENTATION OR WARRANTIES, EXPRESS OR IMPLIED, WITH RESPECT TO THE USE OF THE DRAWING PROVIDED HEREIN, REGARDLESS OF ITS FORMAT OR THE MEANS OF ITS TRANSMISSION. THERE IS NO GUARANTEE OR REPRESENTATION TO THE USER AS TO THE ACCURACY, CURRENCY, SUITABILITY, OR RELIABILITY OF THIS DRAWING FOR ANY PURPOSE. THIS DRAWING AND INFORMATION CONTAINED HEREIN IS FOR GENERAL PRESENTATION PURPOSES ONLY. THE DRAWING IS NOT INTENDED FOR USE ON ENGINEERING DESIGN PLANS. THIS DRAWING AND THE INFORMATION CONTAINED THEREIN IS THE CONFIDENTIAL, PROPRIETARY INFORMATION OF SOLOMON GROUP AND MAY NOT BE USED OR REPRODUCED WITHOUT APPROVAL OF SOLOMON GROUP. COPYRIGHT SOLOMON GROUP 2017. ALL RIGHTS RESERVED.

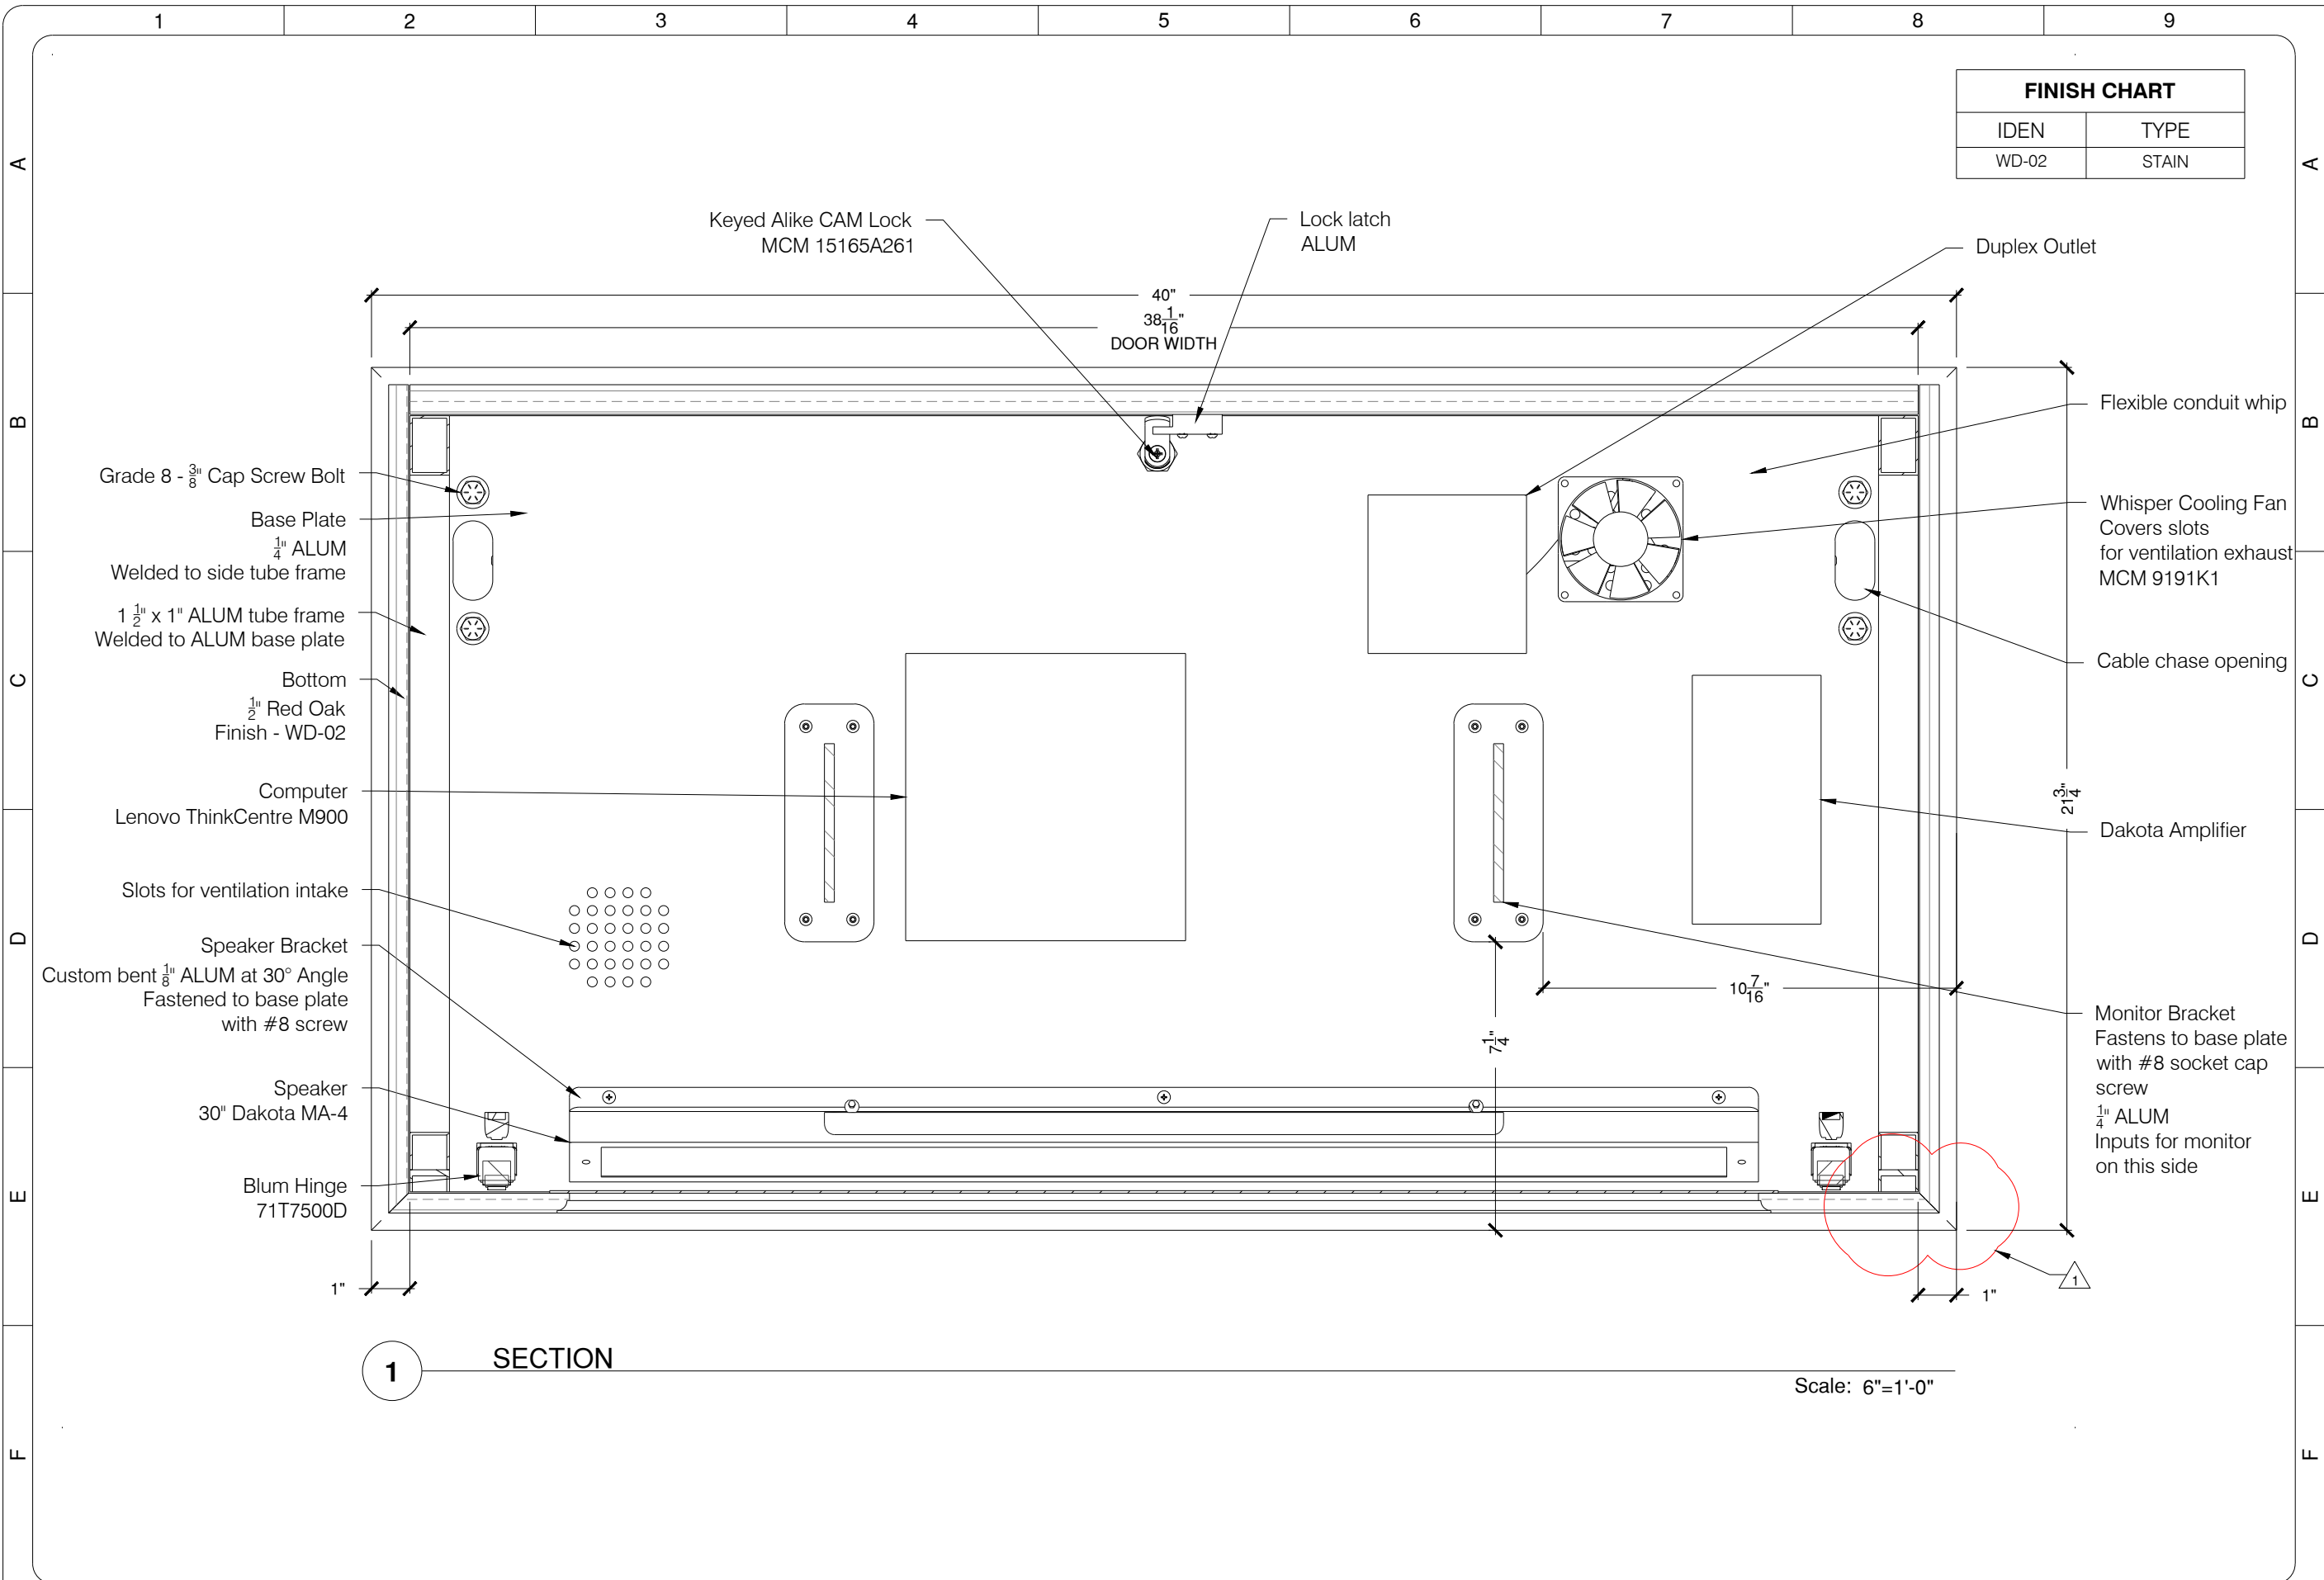

FINISH CHART	
IDEN	TYPE
WD-02	STAIN



Released:		PM	WH	XX
NO:	Date	Revisions:	Drawn By	Review By
0	08/28/2017	Initial Submission	SCHR	MT
1	7/11/2017	REVISION 1	SCHR	MT
2				XX
3				XX
4				XX

Client Approval

Signature: \_\_\_\_\_ Date: \_\_\_\_\_


☐ Approved ☐ Approved As Noted ☐ Revise And Resubmit

☒ Review & Return ☐ For Information Only

PROJECT MANAGER  
Whitney Hines

CONTACT INFORMATION  
whitney.hines@solomongroup.com

STANDARD TOLERANCES  
DIMENSIONS IN INCHES  
FRACTIONS DECIMALS  
XX ±.100" DIMENSION 1/16" ±.005" DIMENSION 1/32" ±.005" DIMENSION 1/64" ±.005" DIMENSION 1/128" ±.005" DIMENSION 1/256" ±.005" DIMENSION 1/512" ±.005" DIMENSION 1/1024" ±.005" DIMENSION 1/2048" ±.005" DIMENSION 1/4096" ±.005" DIMENSION 1/8192" ±.005" DIMENSION 1/16384" ±.005" DIMENSION 1/32768" ±.005" DIMENSION 1/65536" ±.005" DIMENSION 1/131072" ±.005" DIMENSION 1/262144" ±.005" DIMENSION 1/524288" ±.005" DIMENSION 1/1048576" ±.005" DIMENSION 1/2097152" ±.005" DIMENSION 1/4194304" ±.005" DIMENSION 1/8388608" ±.005" DIMENSION 1/16777216" ±.005" DIMENSION 1/33554432" ±.005" DIMENSION 1/67108864" ±.005" DIMENSION 1/134217728" ±.005" DIMENSION 1/268435456" ±.005" DIMENSION 1/536870912" ±.005" DIMENSION 1/1073741824" ±.005" DIMENSION 1/2147483648" ±.005" DIMENSION 1/4294967296" ±.005" DIMENSION 1/8589934592" ±.005" DIMENSION 1/17179869184" ±.005" DIMENSION 1/34359738368" ±.005" DIMENSION 1/68719476736" ±.005" DIMENSION 1/137438953472" ±.005" DIMENSION 1/274877906944" ±.005" DIMENSION 1/549755813888" ±.005" DIMENSION 1/1099511627776" ±.005" DIMENSION 1/2199023255552" ±.005" DIMENSION 1/4398046511104" ±.005" DIMENSION 1/8796093022208" ±.005" DIMENSION 1/17592186044416" ±.005" DIMENSION 1/35184372088832" ±.005" DIMENSION 1/70368744177664" ±.005" DIMENSION 1/140737488355328" ±.005" DIMENSION 1/281474976710656" ±.005" DIMENSION 1/562949953421312" ±.005" DIMENSION 1/1125899906842624" ±.005" DIMENSION 1/2251799813685248" ±.005" DIMENSION 1/4503599627370496" ±.005" DIMENSION 1/9007199254740992" ±.005" DIMENSION 1/18014398509481984" ±.005" DIMENSION 1/36028797018963968" ±.005" DIMENSION 1/72057594037927936" ±.005" DIMENSION 1/144115188075855872" ±.005" DIMENSION 1/288230376151711744" ±.005" DIMENSION 1/576460752303423488" ±.005" DIMENSION 1/1152921504606846976" ±.005" DIMENSION 1/2305843009213693952" ±.005" DIMENSION 1/4611686018427387904" ±.005" DIMENSION 1/9223372036854775808" ±.005" DIMENSION 1/18446744073709551616" ±.005" DIMENSION 1/36893488147419103232" ±.005" DIMENSION 1/73786976294838206464" ±.005" DIMENSION 1/147573952589676412928" ±.005" DIMENSION 1/295147905179352825856" ±.005" DIMENSION 1/590295810358705651712" ±.005" DIMENSION 1/1180591620717411303424" ±.005" DIMENSION 1/2361183241434822606848" ±.005" DIMENSION 1/4722366482869645213696" ±.005" DIMENSION 1/9444732965739290427392" ±.005" DIMENSION 1/18889465931478580854784" ±.005" DIMENSION 1/37778931862957161709568" ±.005" DIMENSION 1/75557863725914323419136" ±.005" DIMENSION 1/151115727451828646838272" ±.005" DIMENSION 1/302231454903657293676544" ±.005" DIMENSION 1/604462909807314587353088" ±.005" DIMENSION 1/1208925819614629174706176" ±.005" DIMENSION 1/2417851639229258349412352" ±.005" DIMENSION 1/4835703278458516698824704" ±.005" DIMENSION 1/9671406556917033397649408" ±.005" DIMENSION 1/19342813113834066795298816" ±.005" DIMENSION 1/38685626227668133590597632" ±.005" DIMENSION 1/77371252455336267181195264" ±.005" DIMENSION 1/154742504910672534362390528" ±.005" DIMENSION 1/309485009821345068724781056" ±.005" DIMENSION 1/618970019642690137449562112" ±.005" DIMENSION 1/1237940039285380274899124224" ±.005" DIMENSION 1/2475880078570760549798248448" ±.005" DIMENSION 1/4951760157141521099596496896" ±.005" DIMENSION 1/9903520314283042199192993792" ±.005" DIMENSION 1/19807040628566084398385987584" ±.005" DIMENSION 1/39614081257132168796771975168" ±.005" DIMENSION 1/79228162514264337593543950336" ±.005" DIMENSION 1/158456325028528675187087900672" ±.005" DIMENSION 1/316912650057057350374175801344" ±.005" DIMENSION 1/633825300114114700748351602688" ±.005" DIMENSION 1/1267650600228229401496703205376" ±.005" DIMENSION 1/2535301200456458802993406410752" ±.005" DIMENSION 1/5070602400912917605986812821504" ±.005" DIMENSION 1/10141204801825835211973625643008" ±.005" DIMENSION 1/20282409603651670423947251286016" ±.005" DIMENSION 1/40564819207303340847894502572032" ±.005" DIMENSION 1/81129638414606681695789005144064" ±.005" DIMENSION 1/162259276829213363391578010288128" ±.005" DIMENSION 1/324518553658426726783156020576256" ±.005" DIMENSION 1/649037107316853453566312041152512" ±.005" DIMENSION 1/1298074214633706907132624082305024" ±.005" DIMENSION 1/2596148429267413814265248164610048" ±.005" DIMENSION 1/5192296858534827628530496329220096" ±.005" DIMENSION 1/10384593717069655257060992658440192" ±.005" DIMENSION 1/20769187434139310514121985316880384" ±.005" DIMENSION 1/41538374868278621028243970633760768" ±.005" DIMENSION 1/83076749736557242056487941267521536" ±.005" DIMENSION 1/166153499473114484112975882535043072" ±.005" DIMENSION 1/332306998946228968225951765070086144" ±.005" DIMENSION 1/664613997892457936451903530140172288" ±.005" DIMENSION 1/1329227995784915872903807060280344576" ±.005" DIMENSION 1/2658455991569831745807614120560689152" ±.005" DIMENSION 1/5316911983139663491615228241121378304" ±.005" DIMENSION 1/10633823966279326983230456482242756608" ±.005" DIMENSION 1/21267647932558653966460912964485513216" ±.005" DIMENSION 1/42535295865117307932921825928971026432" ±.005" DIMENSION 1/85070591730234615865843651857942052864" ±.005" DIMENSION 1/170141183460469231731687303715884105728" ±.005" DIMENSION 1/340282366920938463463374607431768211456" ±.005" DIMENSION 1/680564733841876926926749214863536422912" ±.005" DIMENSION 1/1361129467683753853853498429727072845824" ±.005" DIMENSION 1/2722258935367507707706996859454145691648" ±.005" DIMENSION 1/5444517870735015415413993718908291383296" ±.005" DIMENSION 1/10889035741470030830827987437816582766592" ±.005" DIMENSION 1/21778071482940061661655974875633165533184" ±.005" DIMENSION 1/43556142965880123323311949751266331066368" ±.005" DIMENSION 1/87112285931760246646623899502532662132736" ±.005" DIMENSION 1/174224571863520493293247799005065324265472" ±.005" DIMENSION 1/348449143727040986586495598010130648530944" ±.005" DIMENSION 1/696898287454081973172991196020261297061888" ±.005" DIMENSION 1/1393796574908163946345982392040522594123776" ±.005" DIMENSION 1/2787593149816327892691964784081045188247552" ±.005" DIMENSION 1/5575186299632655785383929568162090376495104" ±.005" DIMENSION 1/11150372599265311570767859136324180752990208" ±.005" DIMENSION 1/22300745198530623141535718272648361505980416" ±.005" DIMENSION 1/44601490397061246283071436545296723011960832" ±.005" DIMENSION 1/89202980794122492566142873090593446023921664" ±.005" DIMENSION 1/178405961588244985132285746181186892047843328" ±.005" DIMENSION 1/356811923176489970264571492362373784095686656" ±.005" DIMENSION 1/713623846352979940529142984724747568191373312" ±.005" DIMENSION 1/1427247692705959881058285969449495136382746624" ±.005" DIMENSION 1/2854495385411919762116571938898990272765493248" ±.005" DIMENSION 1/5708990770823839524233143877797980545530986496" ±.005" DIMENSION 1/11417981541647679048466287755595961091061972992" ±.005" DIMENSION 1/22835963083295358096932575511191922182123945984" ±.005" DIMENSION 1/45671926166590716193865151022383844364247891968" ±.005" DIMENSION 1/91343852333181432387730302044767688728495783936" ±.005" DIMENSION 1/182687704666362864775460604089535377456991567872" ±.005" DIMENSION 1/365375409332725729550921208179070754913983135744" ±.005" DIMENSION 1/730750818665451459101842416358141509827966271488" ±.005" DIMENSION 1/1461501637330902918203684832716283019655932542976" ±.005" DIMENSION 1/2923003274661805836407369665432566039311865085952" ±.005" DIMENSION 1/5846006549323611672814739330865132078623730171904" ±.005" DIMENSION 1/11692013098647223345629478661730264157247460343808" ±.005" DIMENSION 1/23384026197294446691258957323460528314494920687616" ±.005" DIMENSION 1/46768052394588893382517914646921056628989841375232" ±.005" DIMENSION 1/93536104789177786765035829293842113257979682750464" ±.005" DIMENSION 1/187072209578355573530071658587684226515959365500928" ±.005" DIMENSION 1/374144419156711147060143317175368453031918731001856" ±.005" DIMENSION 1/748288838313422294120286634350736906063837462003712" ±.005" DIMENSION 1/1496577676626844588240573268701473812127674924007424" ±.005" DIMENSION 1/2993155353253689176481146537402947624255349848014848" ±.005" DIMENSION 1/5986310706507378352962293074805895248510699696029696" ±.005" DIMENSION 1/11972621413014756705924586149611790497021399392059392" ±.005" DIMENSION 1/23945242826029513411849172299223580994042798784118784" ±.005" DIMENSION 1/47890485652059026823698344598447161988085597568237568" ±.005" DIMENSION 1/95780971304118053647396689196894323976171195136475136" ±.005" DIMENSION 1/191561942608236107294793378393788647952342390272950272" ±.005" DIMENSION 1/383123885216472214589586756787577295904684780545900544" ±.005" DIMENSION 1/766247770432944429179173513575154591809369561091801088" ±.005" DIMENSION 1/1532495540865888858358347027150309183618739122183602176" ±.005" DIMENSION 1/3064991081731777716716694054300618367237478244367204352" ±.005" DIMENSION 1/6129982163463555433433388108601236734474956488734408704" ±.005" DIMENSION 1/12259964326927110866866776217202473468949912977468817408" ±.005" DIMENSION 1/24519928653854221733733552434404946937899825954937634816" ±.005" DIMENSION 1/49039857307708443467467104868809893875799651909875269632" ±.005" DIMENSION 1/98079714615416886934934209737619787751599303819750539264" ±.005" DIMENSION 1/196159429230833773869868419475239575503198607639501078528" ±.005" DIMENSION 1/392318858461667547739736838950479151006397215279002157056" ±.005" DIMENSION 1/784637716923335095479473677900958302012794430558004314112" ±.005" DIMENSION 1/1569275433846670190958947355801916604025588861116008628224" ±.005" DIMENSION 1/3138550867693340381917894711603833208051177722232017256448" ±.005" DIMENSION 1/6277101735386680763835789423207666416102355444464034512896" ±.005" DIMENSION 1/12554203470773361527671578846415332832204710888928069025792" ±.005" DIMENSION 1/25108406941546723055343157692830665664409421777856138051584" ±.005" DIMENSION 1/50216813883093446110686315385661331328818843555712276103168" ±.005" DIMENSION 1/100433627766186892221372630771322662657637687111424552206336" ±.005" DIMENSION 1/200867255532373784442745261542645325315275374222849104412672" ±.005" DIMENSION 1/401734511064747568885490523085290650630550748445698208825344" ±.005" DIMENSION 1/803469022129495137770981046170581301261101496891396417650688" ±.005" DIMENSION 1/1606938044258990275541962092341162602522202993782792835301376" ±.005" DIMENSION 1/3213876088517980551083924184682325205044405987565585670602752" ±.005" DIMENSION 1/6427752177035961102167848369364650410088811975131171341205504" ±.005" DIMENSION 1/12855504354071922204335696738729300820177623950262342682411008" ±.005" DIMENSION 1/25711008708143844408671393477458601640355247900524685364822016" ±.005" DIMENSION 1/51422017416287688817342786954917203280710495801049370729644032" ±.005" DIMENSION 1/102844034832575377634685573909834406561420991602098741459288064" ±.005" DIMENSION 1/205688069665150755269371147819668813122841983204197482918576128" ±.005" DIMENSION 1/411376139330301510538742295639337626245683966408394965837152256" ±.005" DIMENSION 1/822752278660603021077484591278675252491367932816789931674304512" ±.005" DIMENSION 1/1645504557321206042154969182557350504982735865633579863348609024" ±.005" DIMENSION 1/3291009114642412084309938365114701009965471731267159726697218048" ±.005" DIMENSION 1/6582018229284824168619876730229402019930943462534319453394436096" ±.005" DIMENSION 1/13164036458569648337239753460458804039861886925068638906788872192" ±.005" DIMENSION 1/26328072917139296674479506920917608079723773850137277813577744384" ±.005" DIMENSION 1/52656145834278593348959013841835216159447547700274555627155488768" ±.005" DIMENSION 1/105312291668557186697918027683670432318895095400549111254310977536" ±.005" DIMENSION 1/210624583337114373395836055367340864637790190801098222508621955072" ±.005" DIMENSION 1/421249166674228746791672110734681729275580381602196445017243910144" ±.005" DIMENSION 1/842498333348457493583344221469363458551160763204392890034487820288" ±.005" DIMENSION 1/1684996666896914987166688442938726917102321526408785780068975640576" ±.005" DIMENSION 1/3369993333793829974333376885877453834204643052817571560137951281152" ±.005" DIMENSION 1/6739986667587659948666753771754907668409286105635143120275902562304" ±.005" DIMENSION 1/13479973335175319897333507543509815336818572211270286240551805124608" ±.005" DIMENSION 1/26959946670350639794667015087019630673637144422540572481103610249216" ±.005" DIMENSION 1/53919893340701279589334030174039261347274288845081144962207220498432" ±.005" DIMENSION 1/107839786681402559178668060348078522694548577690162289924414440996864" ±.005" DIMENSION 1/215679573362805118357336120696157045389097155380324579848828881993728" ±.005" DIMENSION 1/431359146725610236714672241392314090778194310760649159697657763987456" ±.005" DIMENSION 1/862718293451220473429344482784628181556388621521298319395315527974912" ±.005" DIMENSION 1/1725436586902440946858688965569256363112777243042596638790631055949824" ±.005" DIMENSION 1/3450873173804881893717377931138512726225554486085193277581262111899648" ±.005" DIMENSION 1/6901746347609763787434755862277025452451108972170386555162524223799296" ±.005" DIMENSION 1/13803492695219527574869511724554050904902217944340773110325048447598592" ±.005" DIMENSION 1/27606985390439055149739023449108101809804435888681546220650096895197184" ±.005" DIMENSION 1/55213970780878110299478046898216203619608871777363092441300193790394368" ±.005" DIMENSION 1/110427941561756220598956093796432407239217743554726184882600387580788736" ±.005" DIMENSION 1/220855883123512441197912187592864814478435487109452369765200775161577472" ±.005" DIMENSION 1/441711766247024882395824375185729628956870974218904739530401550323154944" ±.005" DIMENSION 1/883

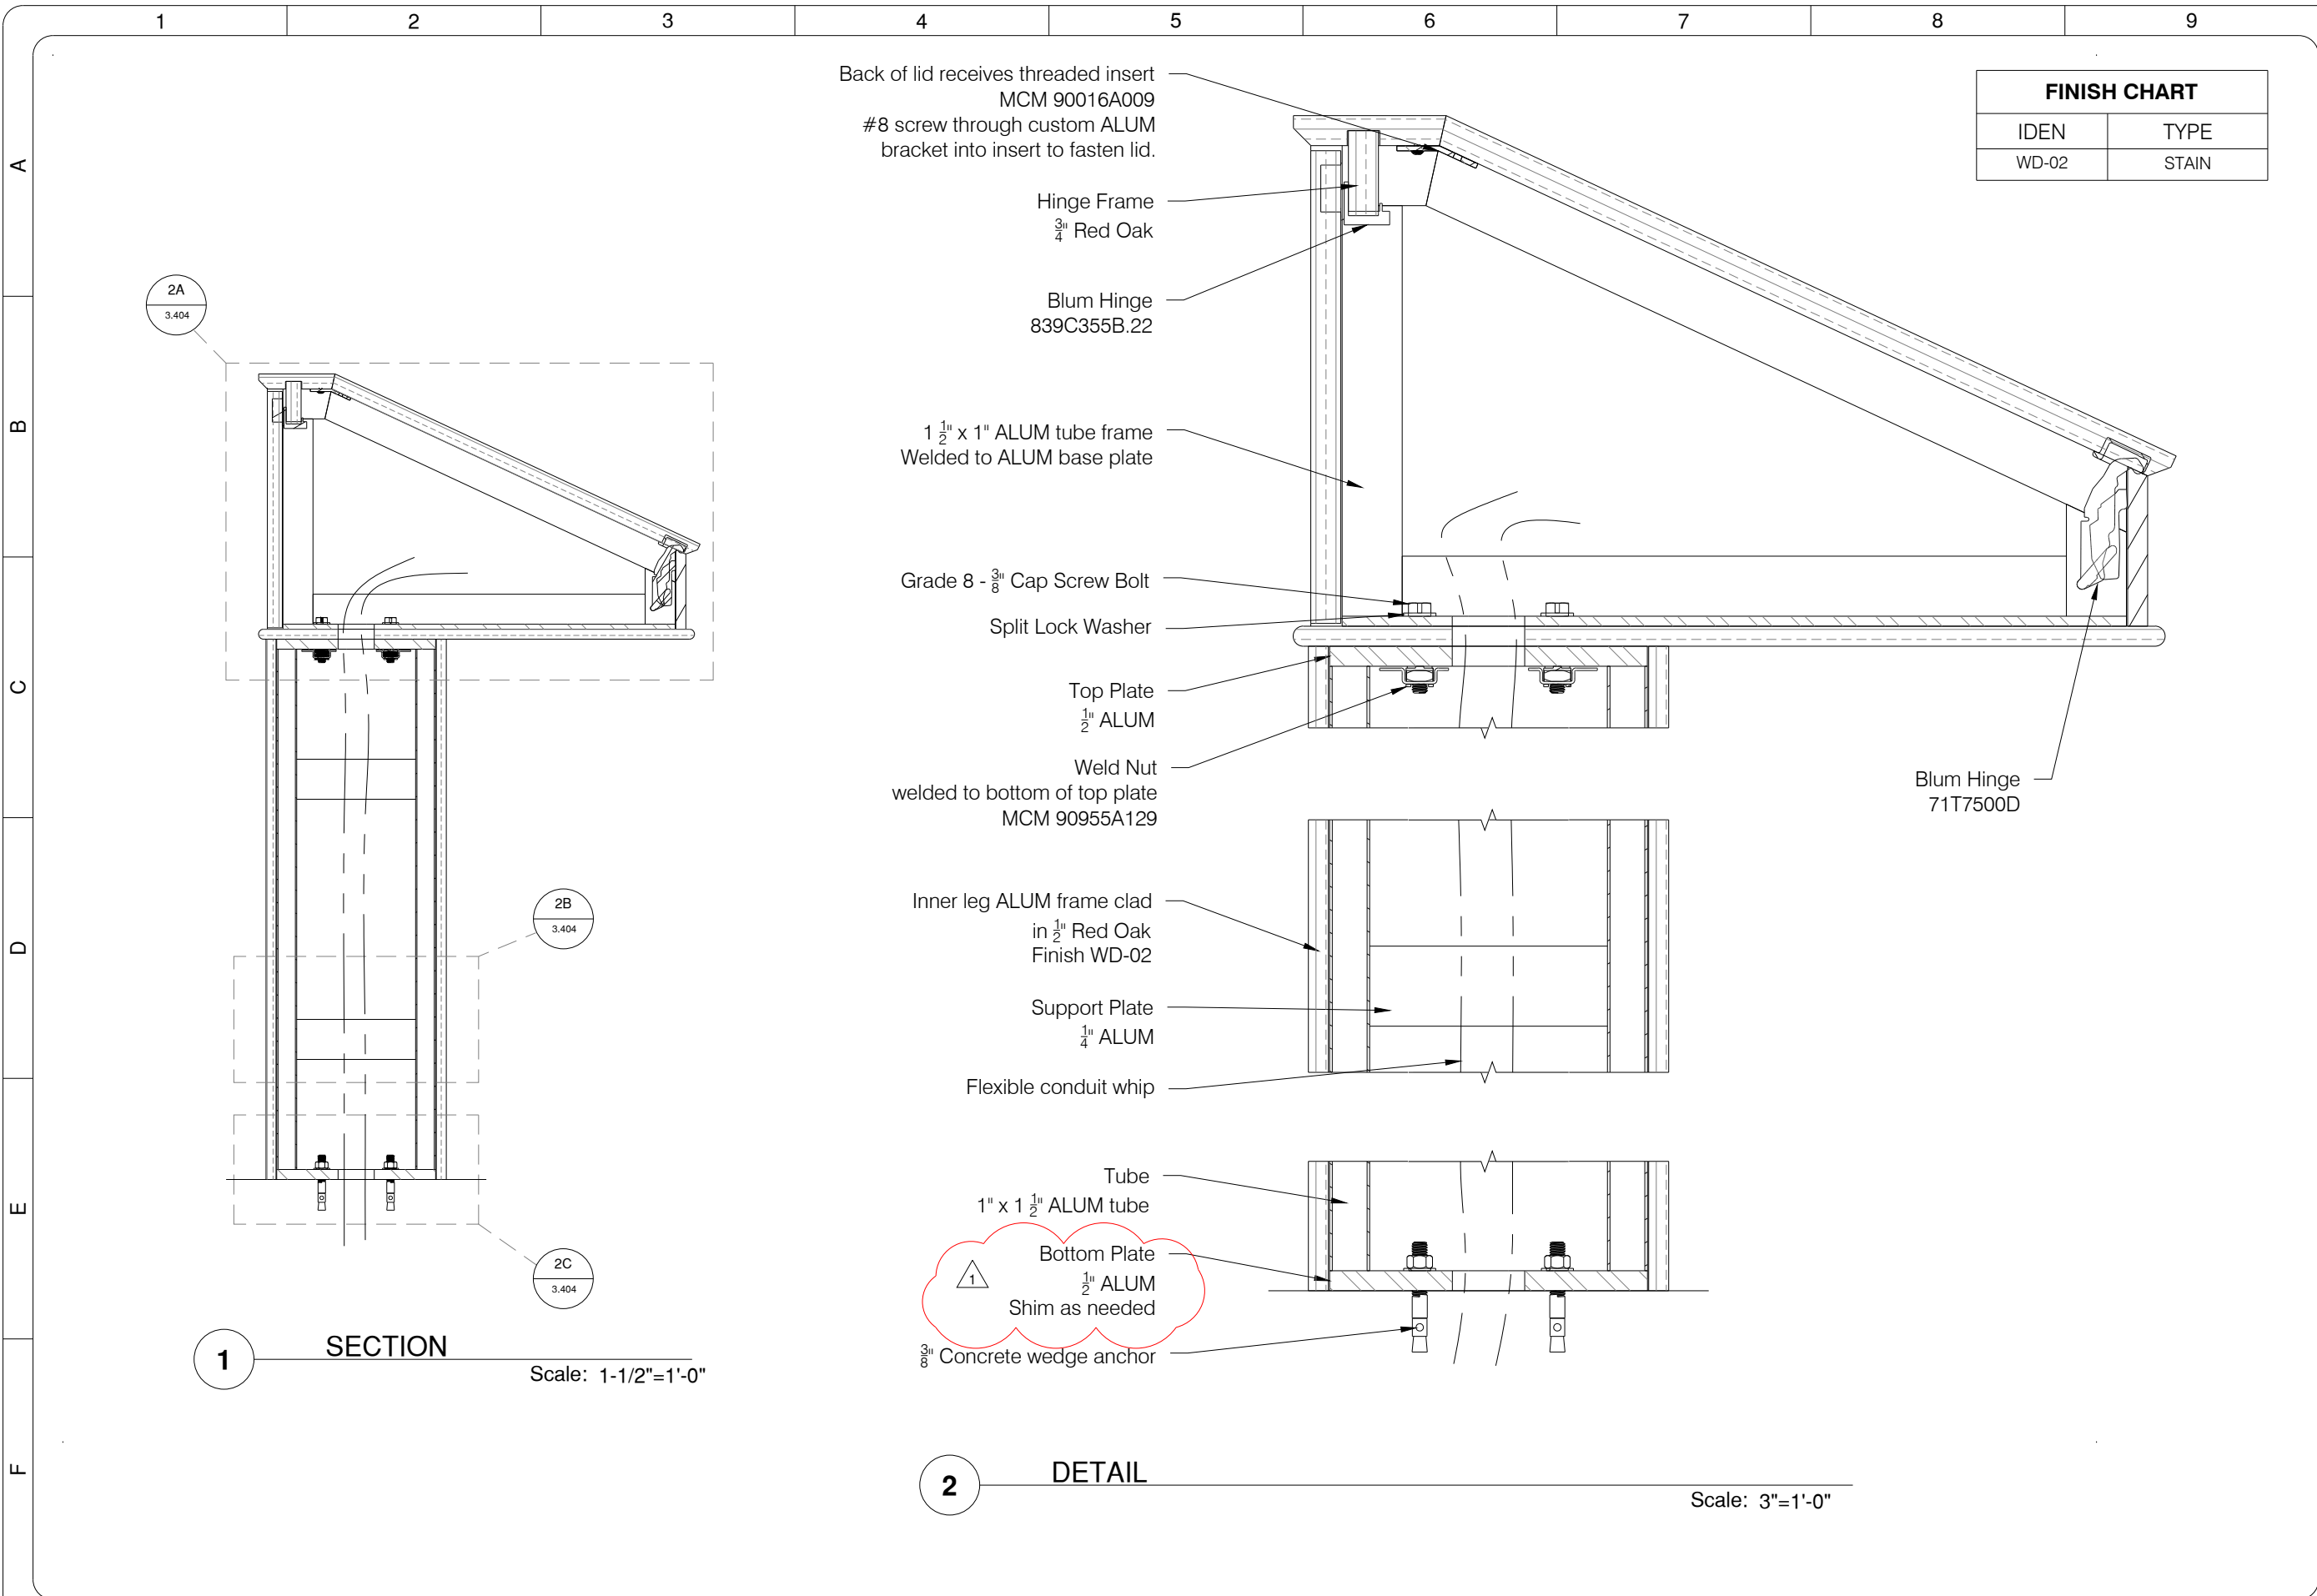

Released:

NO:	Date	Revisions:	Drawn By	Review By	PM	WH	XX	XX
0	08/28/2017	Initial Submission	SCHR	MT				
1	7/11/2017	REVISION 1	SCHR	MT				
2								
3								
4								

11/28/18 12:30 During Drafting 01750002 M. Wines 01 DRAFTING 02 SUBMIT 02 SCENE TYPICAL 01  
© 2017 SOLOMON GROUP. ALL RIGHTS RESERVED.

Client Approval

Signature: \_\_\_\_\_ Date: \_\_\_\_\_

☐ Approved

☐ Approved As Noted

☐ Revise And Resubmit

☒ Review & Return

☐ For Information Only

PROJECT MANAGER

Whitney Hines

CONTACT INFORMATION

whitney.hines@solomongroup.com

STANDARD TOLERANCES  
DIMENSIONS ARE IN INCHES  
UNLESS OTHERWISE SPECIFIED  
FRACTIONS: 1/8" = 0.125"  
DECIMALS: 0.125" = 1/8"  
TOLERANCES: ± 0.005"  
DIMENSION 12" = ± 0.010"  
DIMENSION 12" = ± 0.010"  
DIMENSION 12" = ± 0.010"

PROJECT NAME

Be Washington

PROJECT ADDRESS

3200 MOUNT VERNON HWY, MT VERNON, VA 22121

SHEET TITLE

Station Kiosk Section 3

SG JOB #

6020

Z.03.404







