

solomongroup

THE ART OF BRINGING STORIES TO LIFE.

825 GIROD STREET - NEW ORLEANS, LA 70130

504.252.4500 solomongroup.com

BE WASHINGTON

3200 Mount Vernon Hwy.

Mt. Vernon, VA 22121

WINDOW AND PODIUM PROTOTYPE




2.3

August 4, 2017

INITIAL RELEASE



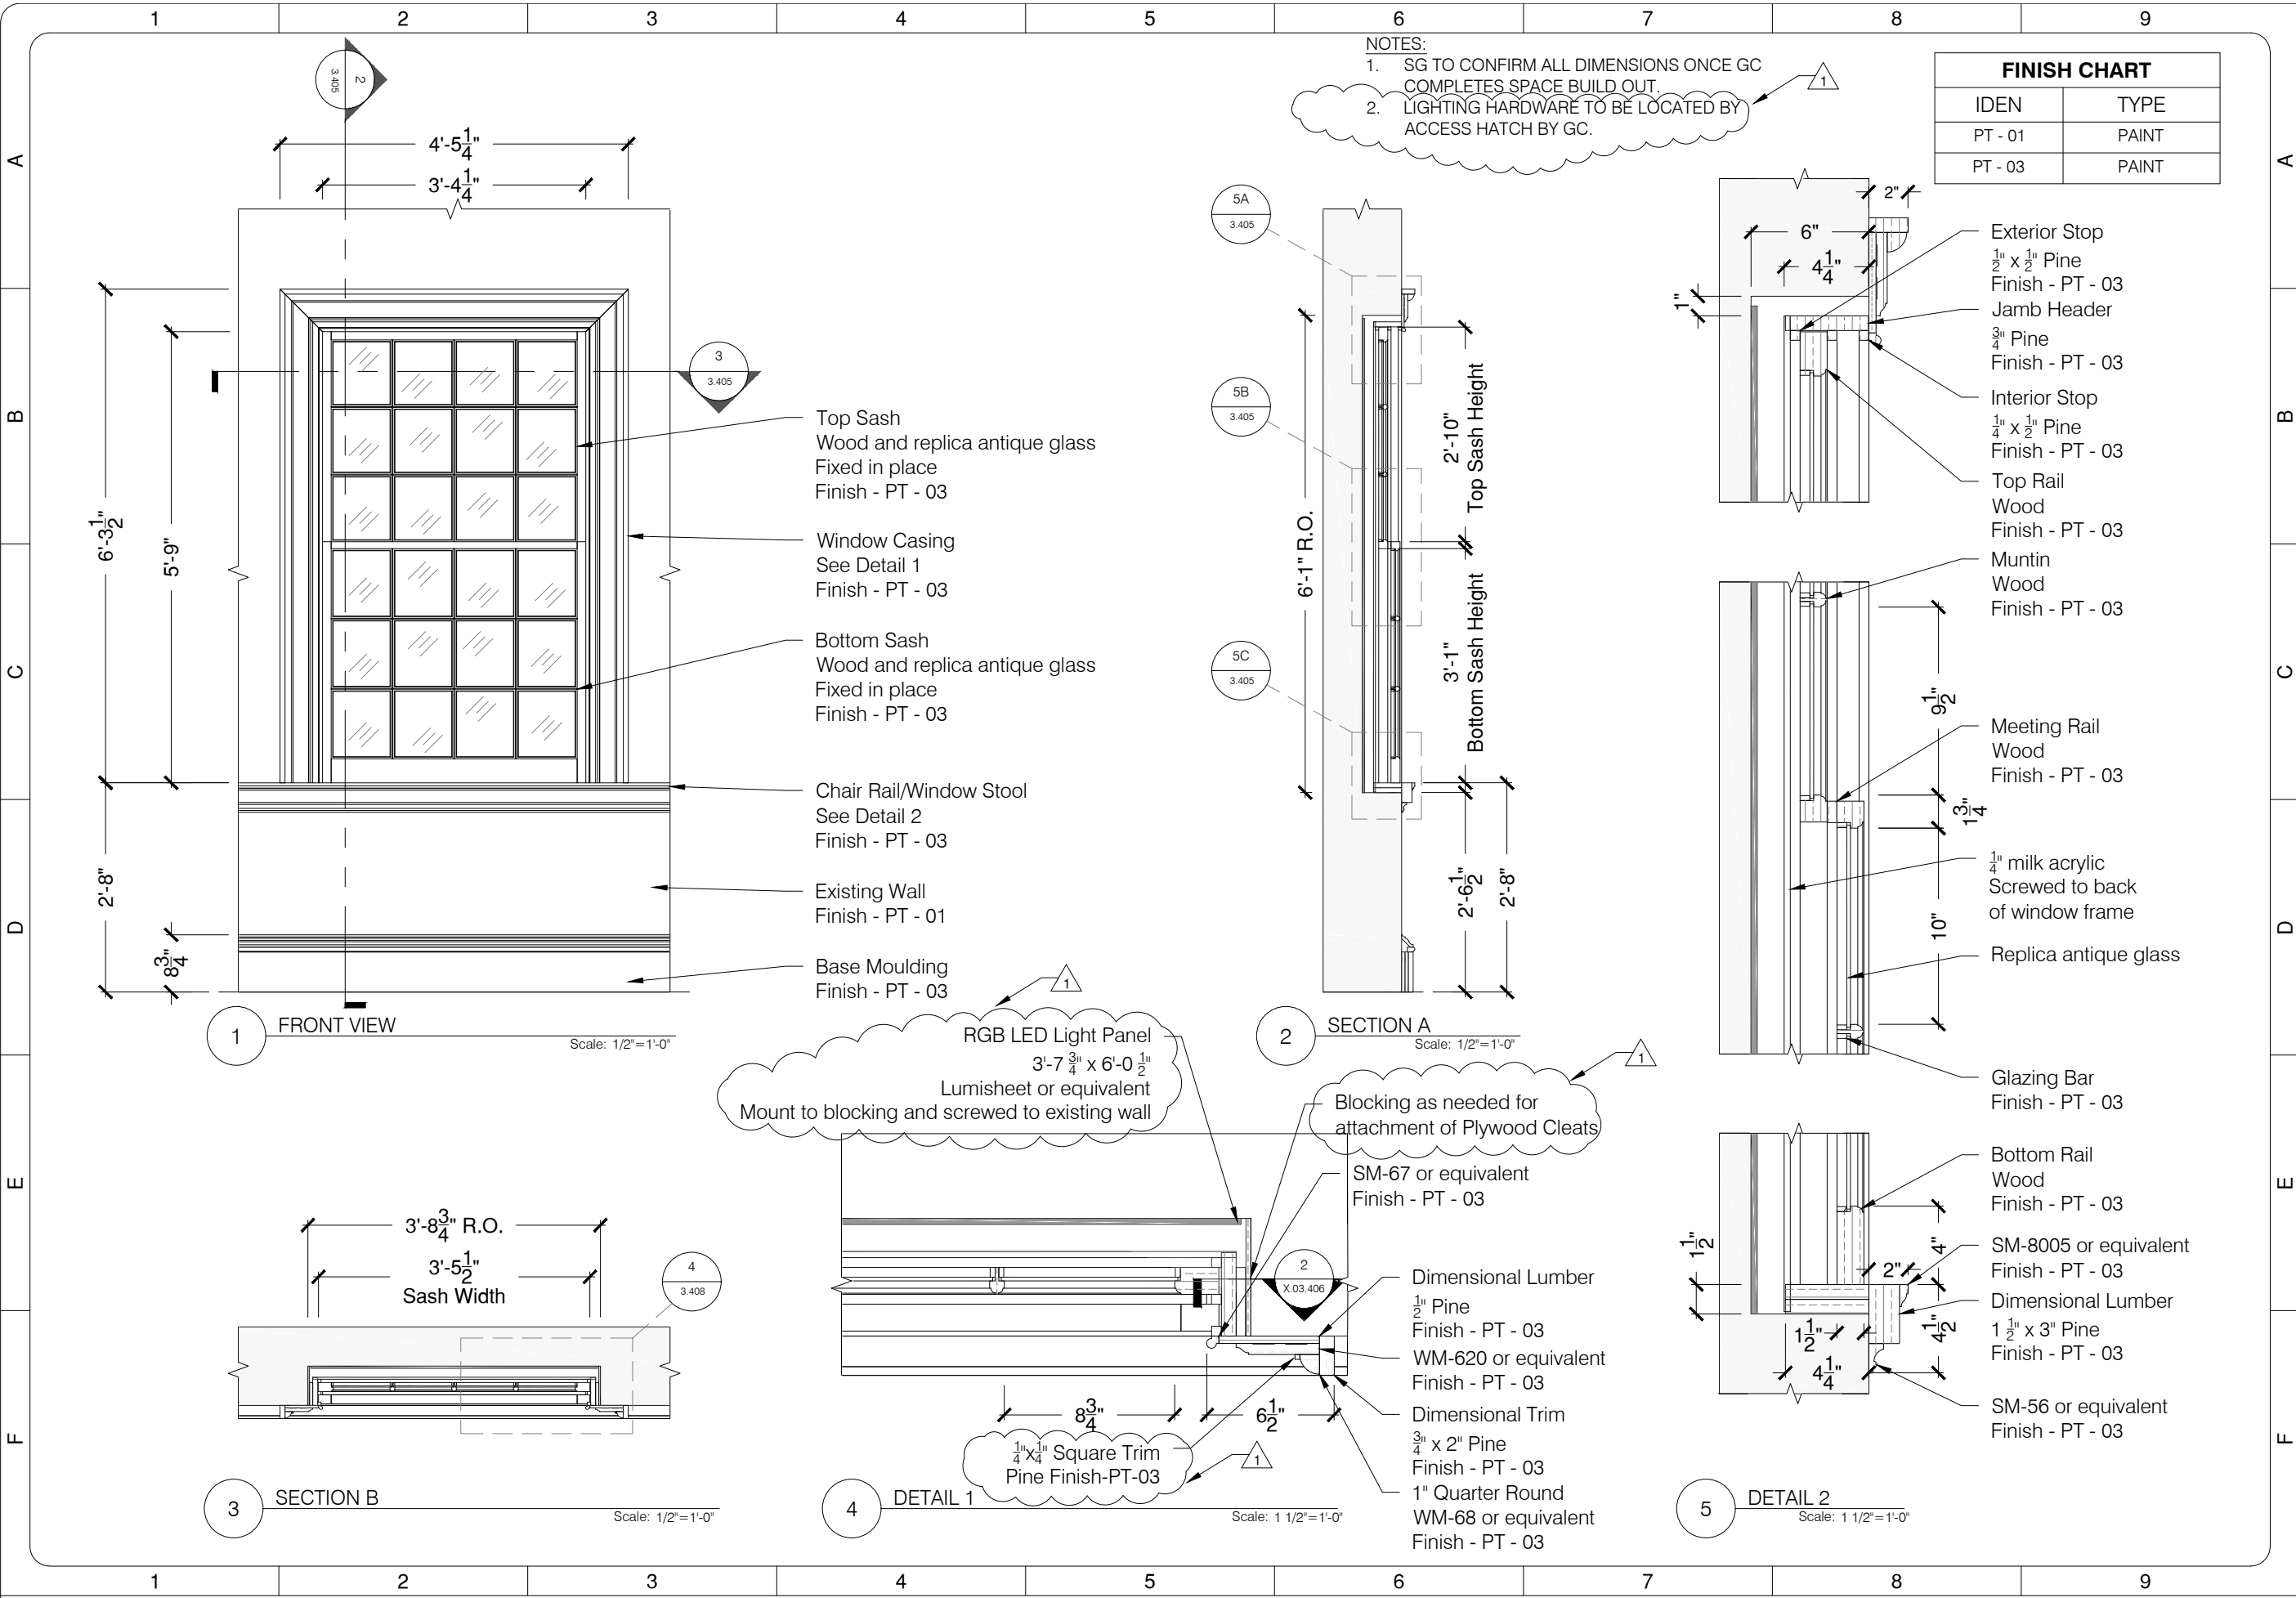

solomongroup
THE ART OF BRINGING STORIES TO LIFE.

Released:

NO:	Date:	Revisions:	Drawn By:	Review By:
0	07/14/2017	INITIAL RELEASE	SCHR	MT
1	08/04/2017	REVISED PER REDLINES	RL	MT
2				
3				
4				

Client Approval

Signature: _____ Date: _____

☒ Review & Return ☐ Approved ☐ Approved As Noted ☐ Revise And Resubmit

PROJECT MANAGER
WHITNEY HINES

CONTACT INFORMATION
whitney.hines@solomongroup.com

PROJECT ADDRESS
3200 MOUNT VERNON HWY, MT VERNON, VA 22121


STANDARD TOLERANCES
DIMENSIONS: 1/8" = 0.125" (1/8" = 0.125")
FINISHES: 1/8" = 0.125" (1/8" = 0.125")
DIMENSIONS: 1/8" = 0.125" (1/8" = 0.125")
FINISHES: 1/8" = 0.125" (1/8" = 0.125")

PROJECT NAME
BE WASHINGTON

SG JOB #
SG6020

SHEET TITLE
Window Light Box Details

X.03.405

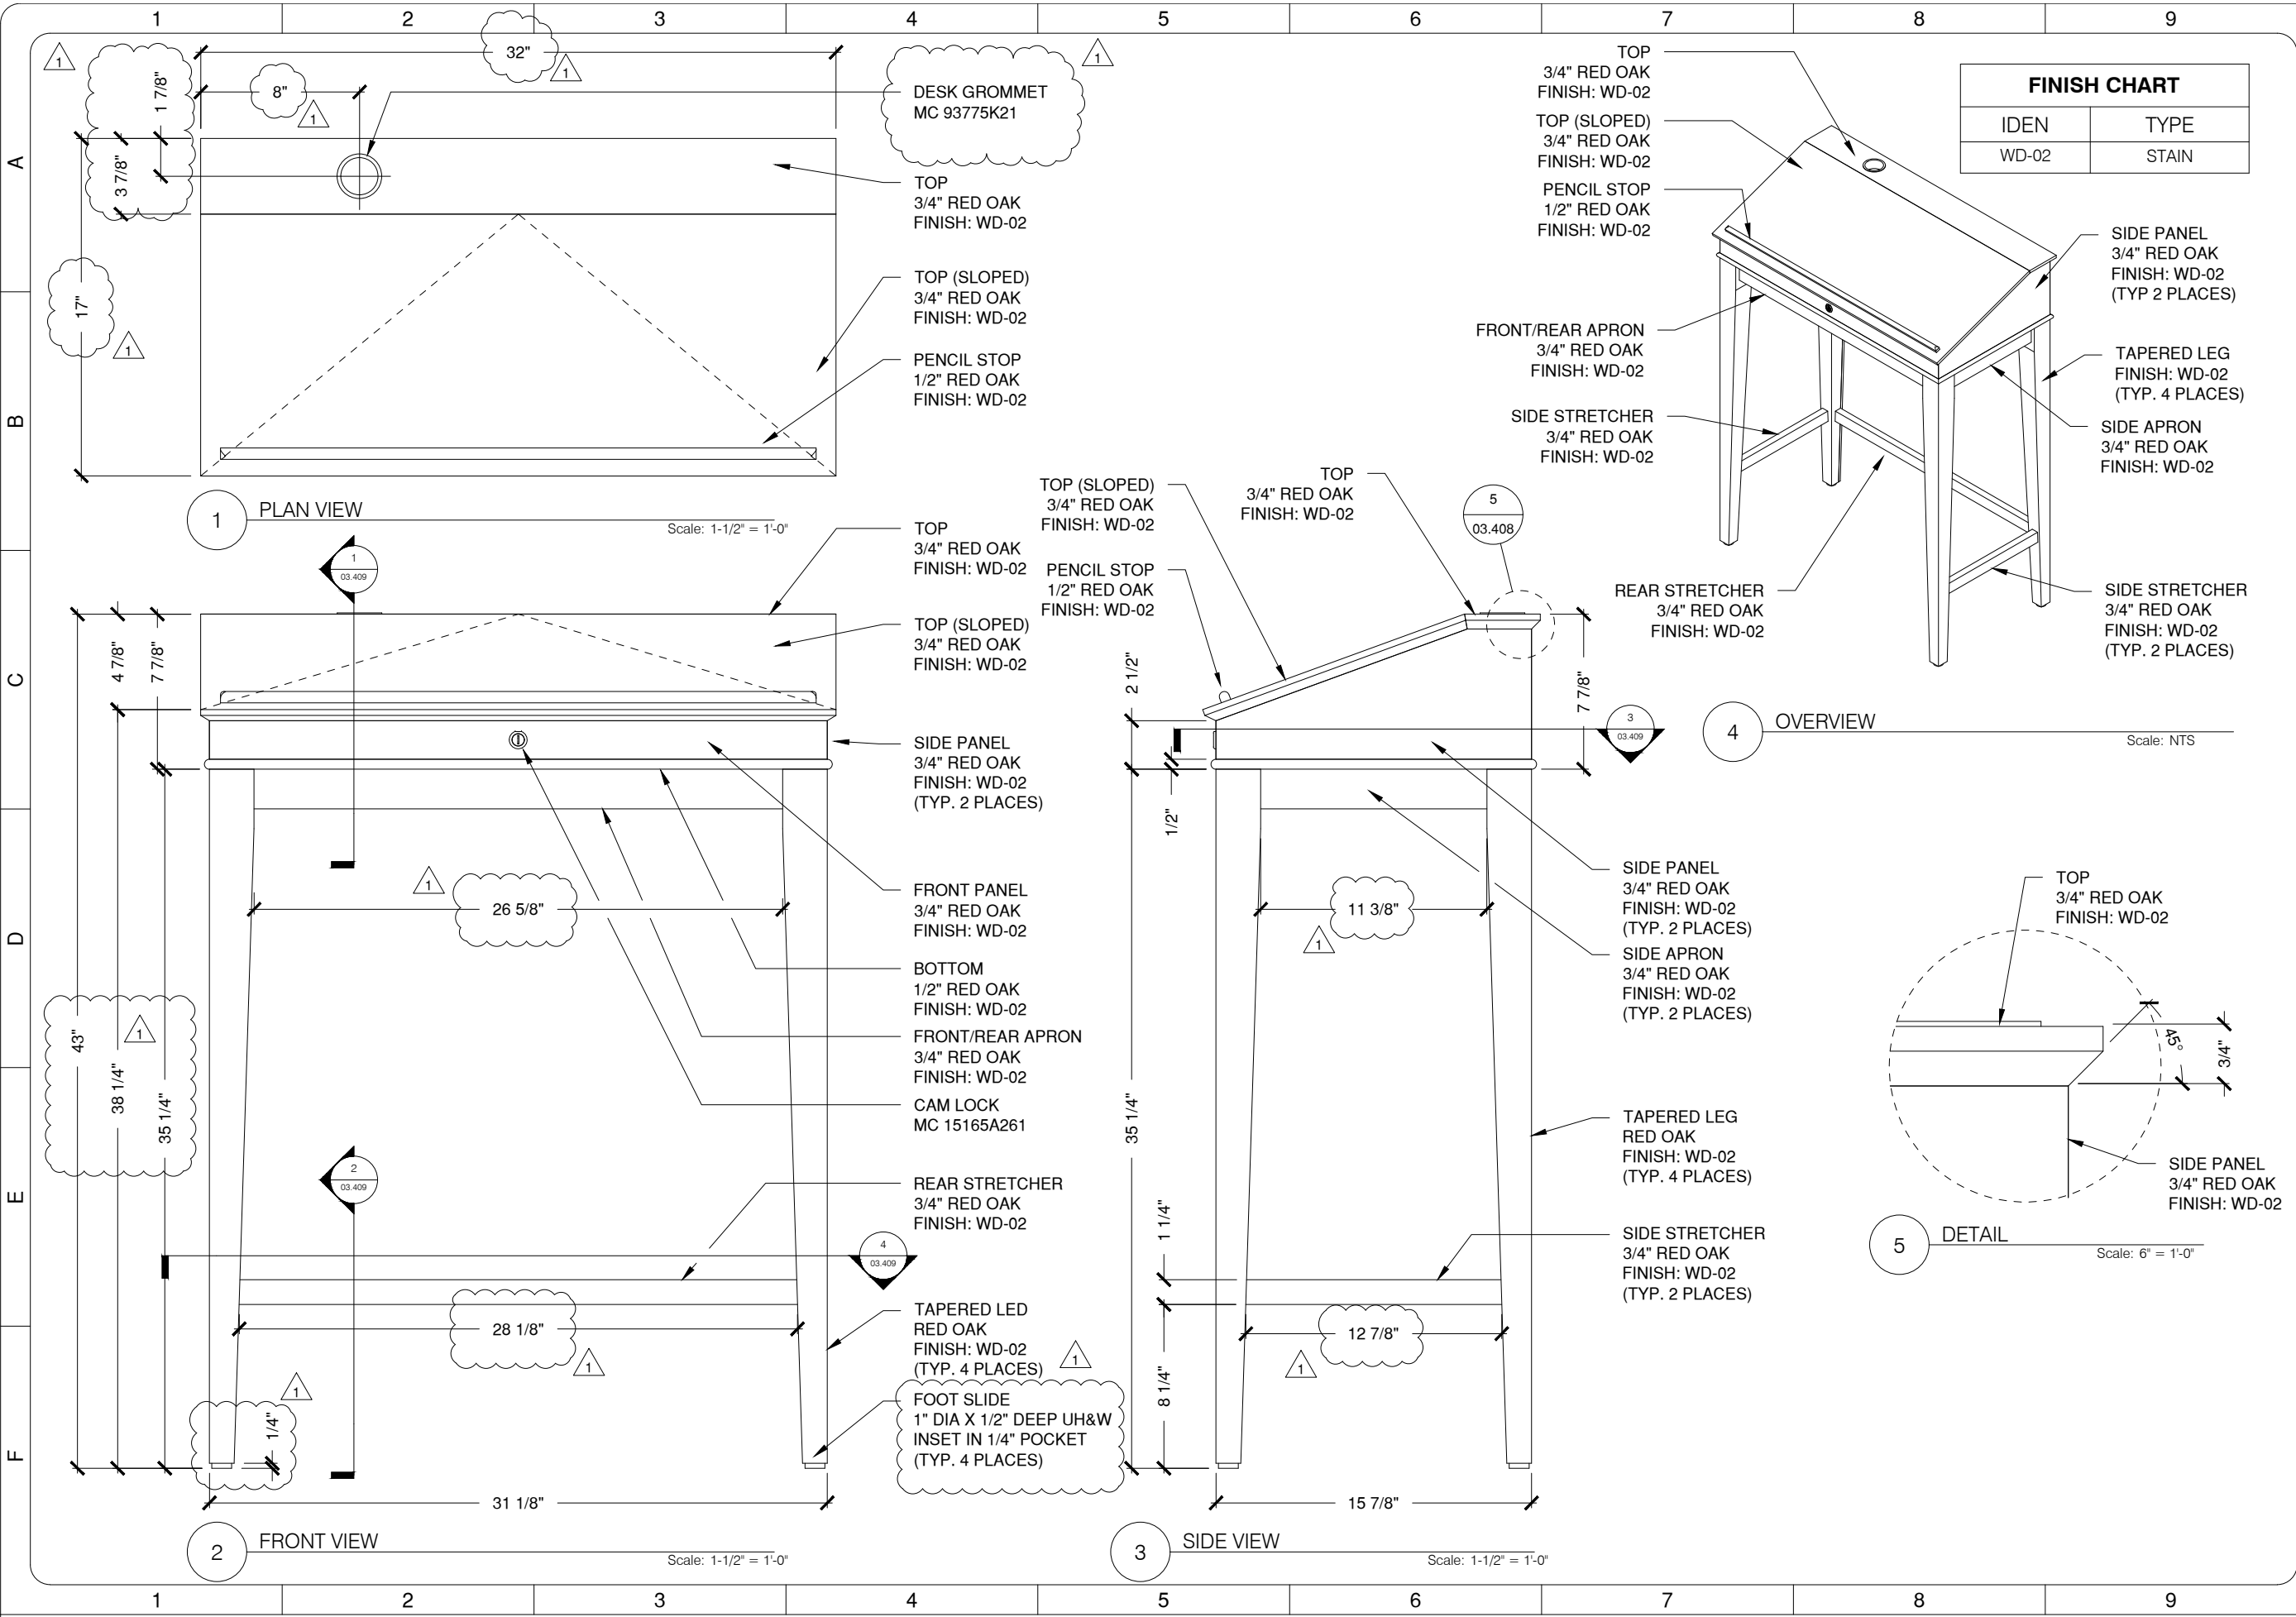

solomongroup
THE ART OF BRINGING STORIES TO LIFE.

Released:

NO: 0
Date: 07/05/2017
Revisions: 1
Initial Submission: 08/04/2017
Revise Per Customer Request: DC
Drawn By: DC
Review By: MT
PM: WH
SCHR: MT
WH: XX
XX: XX
XX: XX

Client Approval

Signature: _____ Date: _____

☒ Review & Return
☐ For Information Only

☐ Approved
☐ Approved As Noted
☐ Revise And Resubmit

PROJECT MANAGER
WHITNEY HINES

CONTACT INFORMATION
whitney.hines@solomongroup.com

STANDARD TOLERANCES

FINISH	WELDING	WELDING TOLERANCE	WELDING TOLERANCE	WELDING TOLERANCE
XX	1/16"	1/16"	1/16"	1/16"
XX	1/16"	1/16"	1/16"	1/16"
XX	1/16"	1/16"	1/16"	1/16"
XX	1/16"	1/16"	1/16"	1/16"

PROJECT NAME
BE WASHINGTON


PROJECT ADDRESS
3200 MOUNT VERNON HWY, MT VERNON, VA 22121

SHEET TITLE
PODIUM OVERVIEW

SG JOB #
6020

X.03.408

DISCLAIMER: SOLOMON GROUP MAKES NO REPRESENTATION OR WARRANTIES, EXPRESS OR IMPLIED, WITH RESPECT TO THE USE OF THE DRAWING PROVIDED HEREIN, REGARDLESS OF ITS FORMAT OR THE MEANS OF ITS TRANSMISSION. THERE IS NO GUARANTEE OR REPRESENTATION TO THE USER AS TO THE ACCURACY, CURRENCY, SUITABILITY, OR RELIABILITY OF THIS DRAWING FOR ANY PURPOSE. THIS DRAWING AND INFORMATION CONTAINED HEREIN IS FOR GENERAL PRESENTATION PURPOSES ONLY. THE DRAWING IS NOT INTENDED FOR USE ON ENGINEERING DESIGN PLANS. THIS DRAWING AND THE INFORMATION CONTAINED THEREIN IS THE CONFIDENTIAL, PROPRIETARY INFORMATION OF SOLOMON GROUP AND MAY NOT BE USED OR REPRODUCED WITHOUT APPROVAL OF SOLOMON GROUP. COPYRIGHT SOLOMON GROUP 2017. ALL RIGHTS RESERVED.

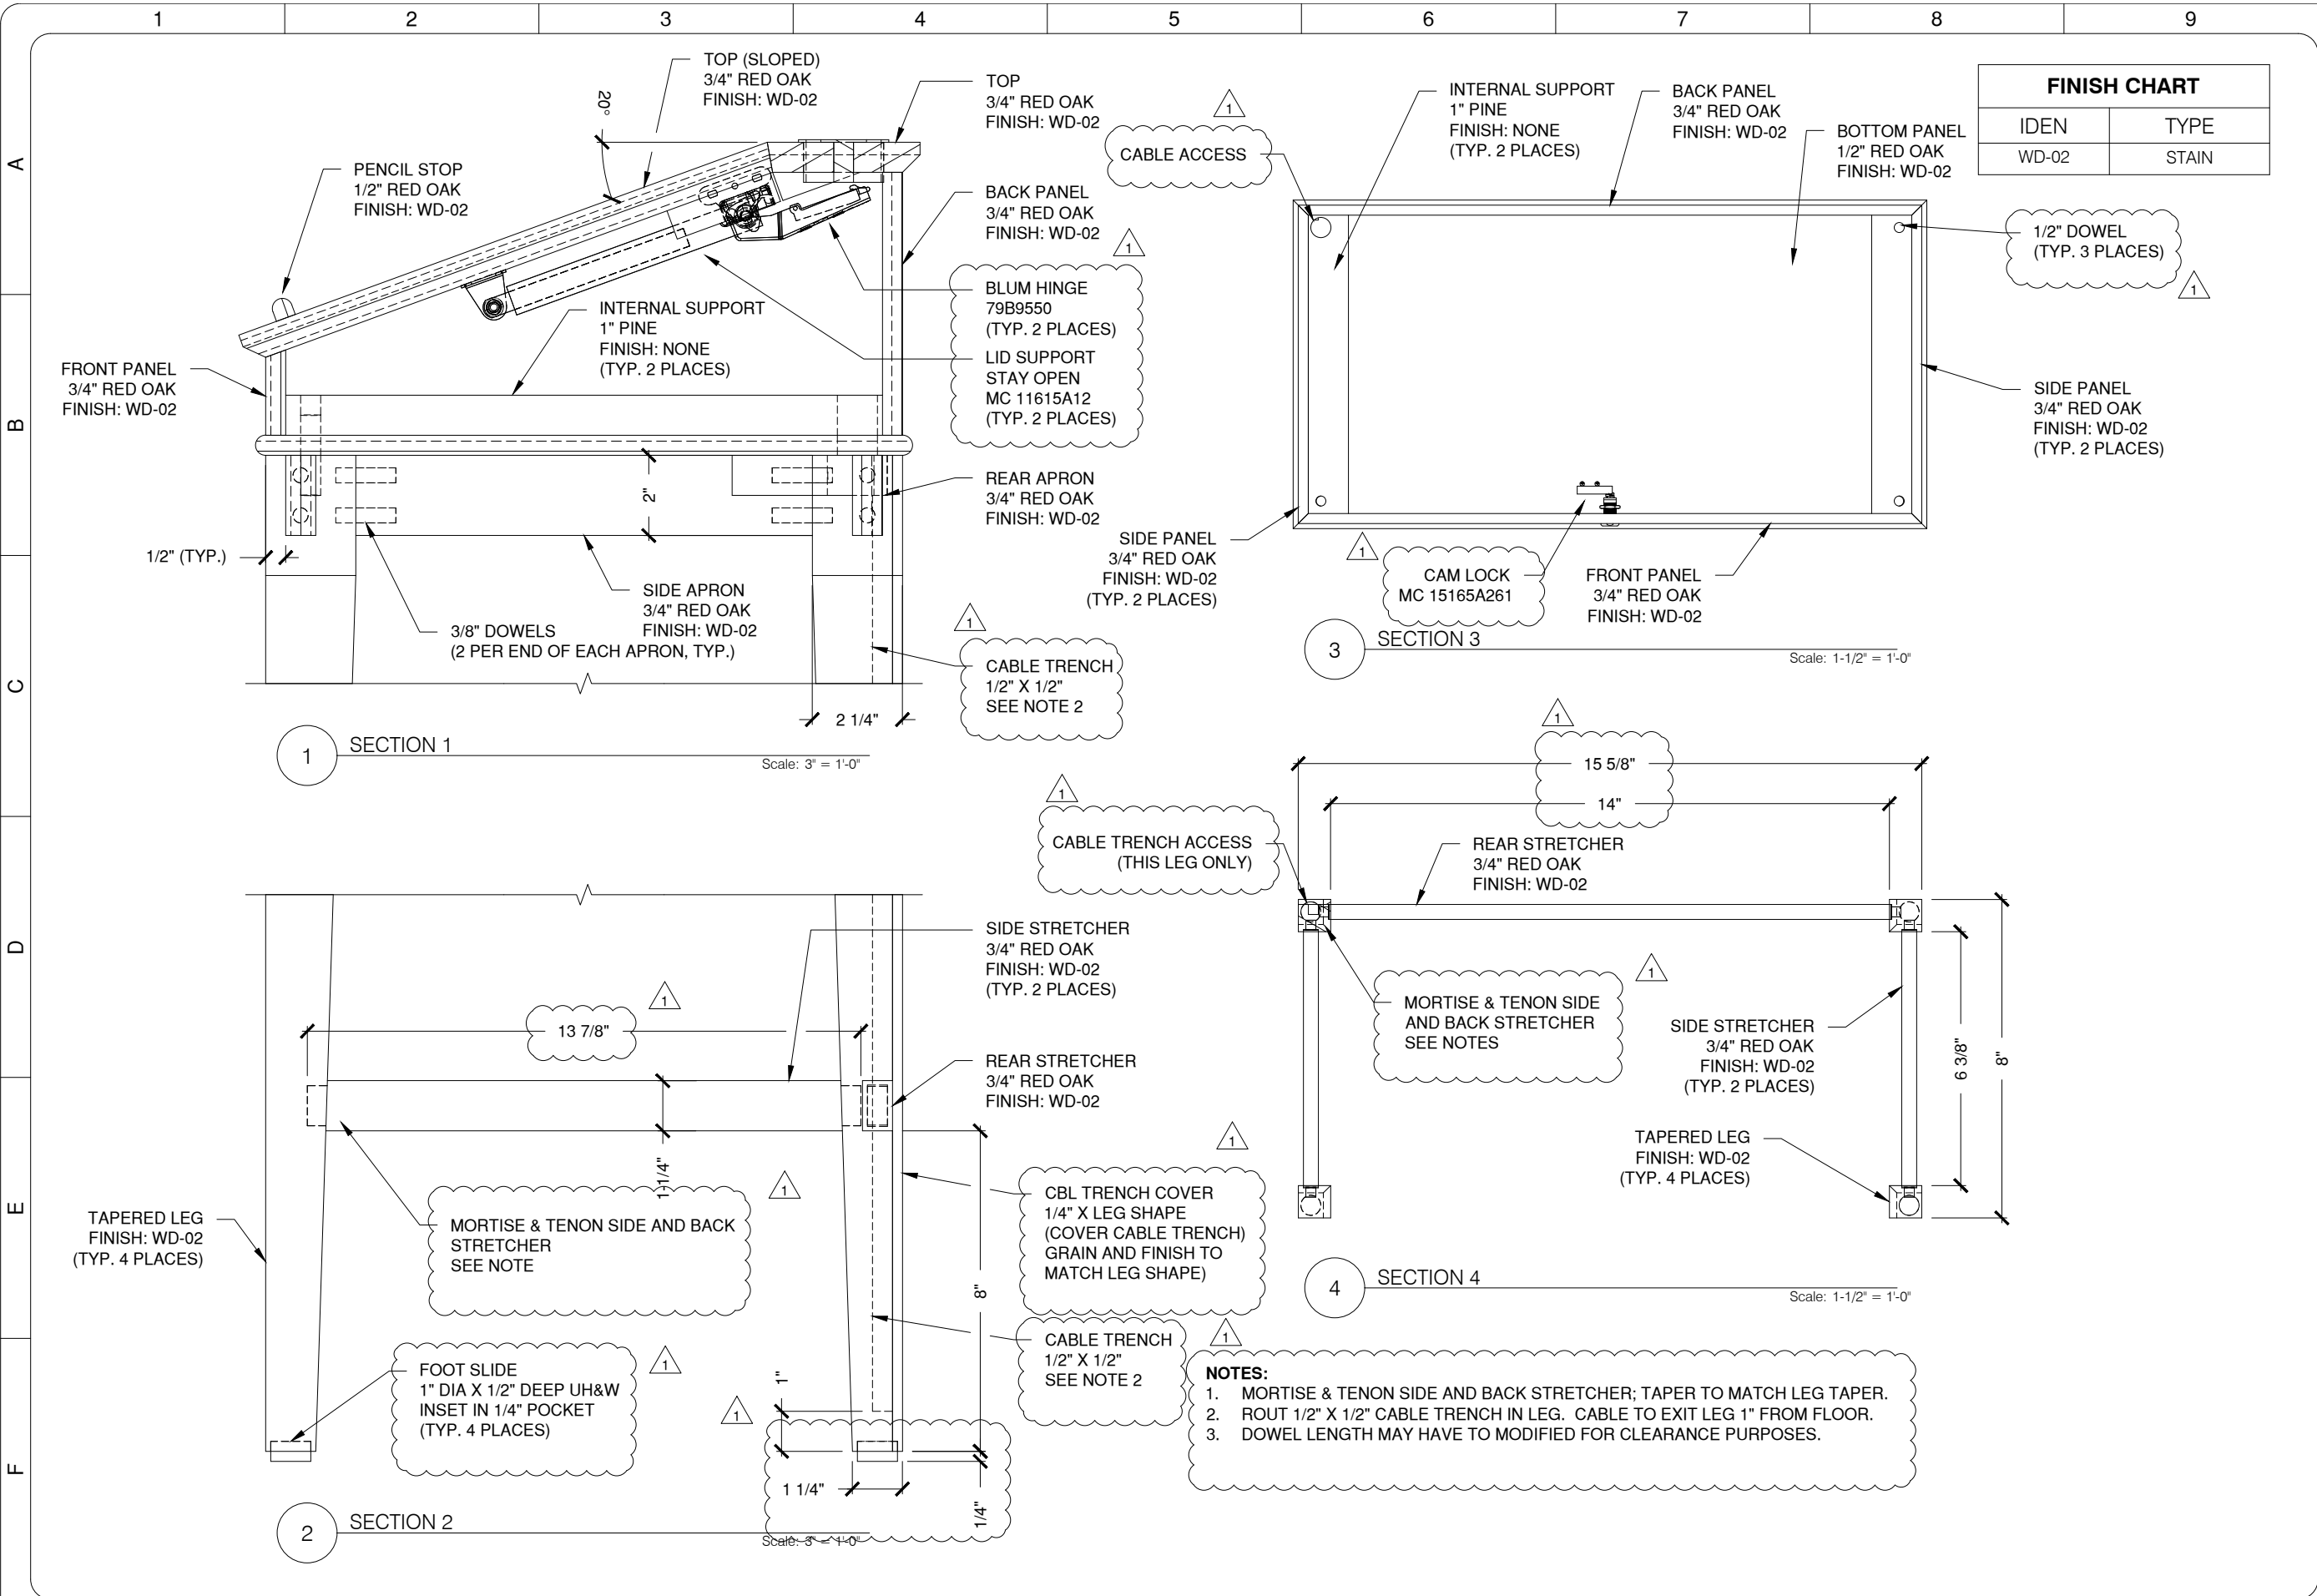

FINISH CHART	
IDEN	TYPE
WD-02	STAIN

- NOTES:**
- MORTISE & TENON SIDE AND BACK STRETCHER; TAPER TO MATCH LEG TAPER.
 - ROUT 1/2" X 1/2" CABLE TRENCH IN LEG. CABLE TO EXIT LEG 1" FROM FLOOR.
 - DOWEL LENGTH MAY HAVE TO MODIFIED FOR CLEARANCE PURPOSES.

THE ART OF BRINGING STORIES TO LIFE.

Released:

NO:	Date:	Revisions:	Drawn By:	Review By:	PM
0	07/05/2017	INITIAL SUBMISSION	DC	SCHR	WH
1	08/04/2017	REVISE PER CUSTOMER REQUEST	DC	MT	WH
2					XX
3					XX
4					XX

Client Approval

Signature: _____ Date: _____

☒ Review & Return ☐ For Information Only

☐ Approved ☐ Approved As Noted ☐ Revise And Resubmit

PROJECT MANAGER
WHITNEY HINES

CONTACT INFORMATION
whitney.hines@solomongroup.com

STANDARD TOLERANCES
DIMENSIONS IN INCHES
FRACTIONS DECIMALS
1/16" 0.0625"
1/8" 0.125"
3/16" 0.1875"
1/4" 0.25"
3/8" 0.375"
1/2" 0.5"
3/4" 0.75"
1" 1.0"
2" 2.0"
4" 4.0"
6" 6.0"
8" 8.0"
10" 10.0"
12" 12.0"


PROJECT NAME
BE WASHINGTON

PROJECT ADDRESS
3200 MOUNT VERNON HWY., MT VERNON, VA 22121

SHEET TITLE
PODIUM SECTIONS


SG JOB #
6020

X.03.409

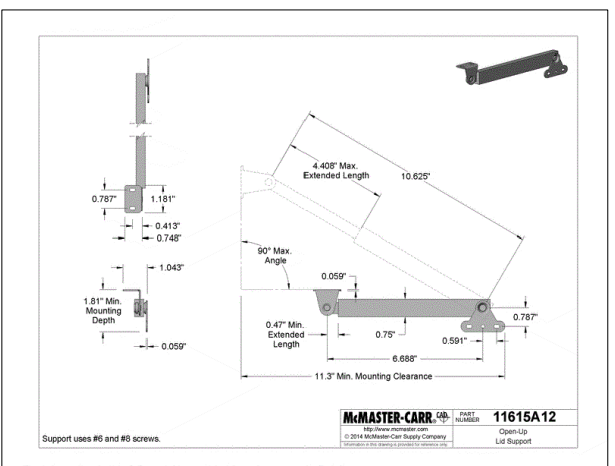


1) LID SUPPORT

Scale: NTS

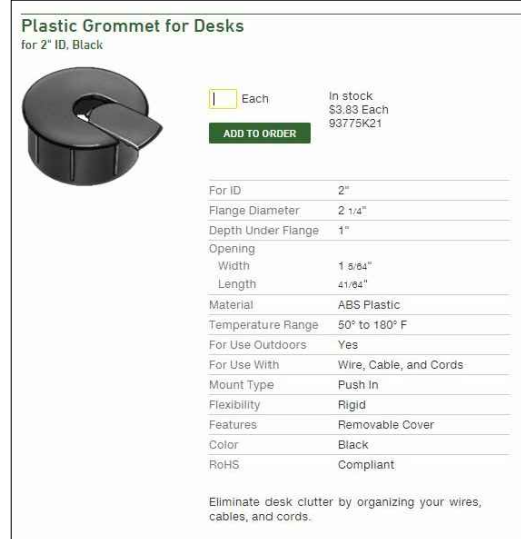


2 DESK GROMMET

Scale: NTS

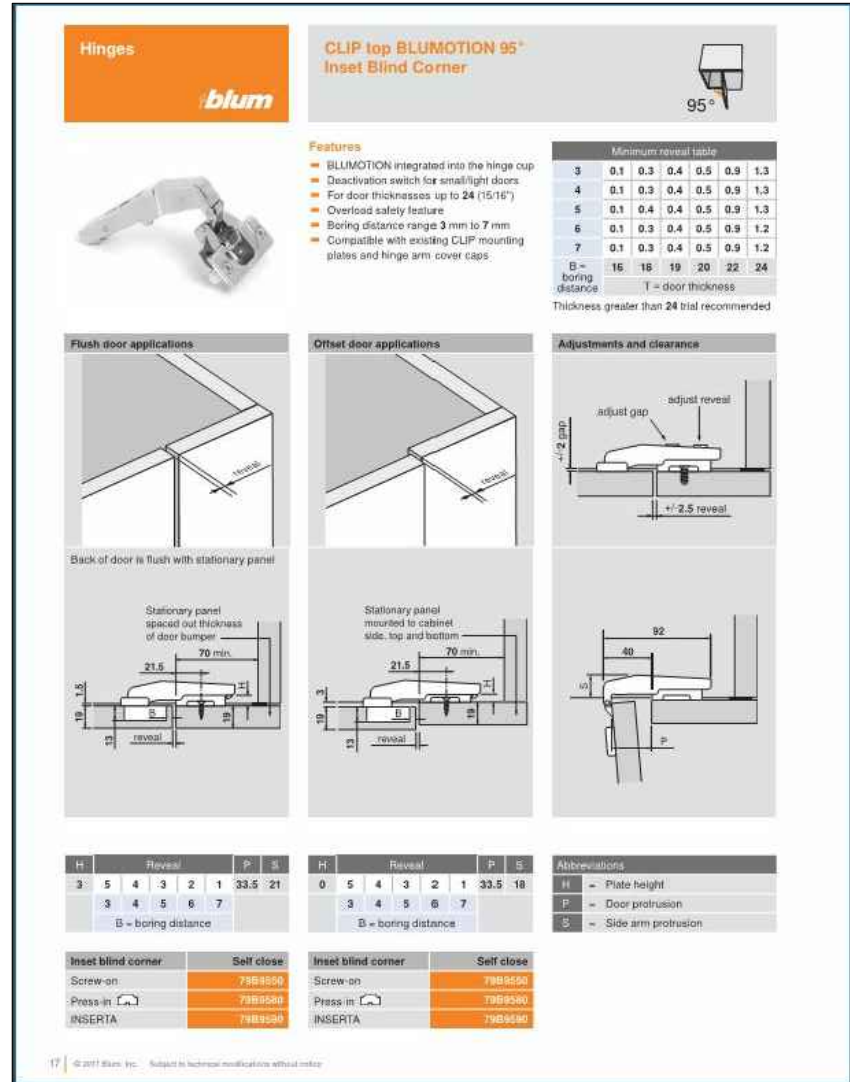

3 LID HINGE

Scale: NTS

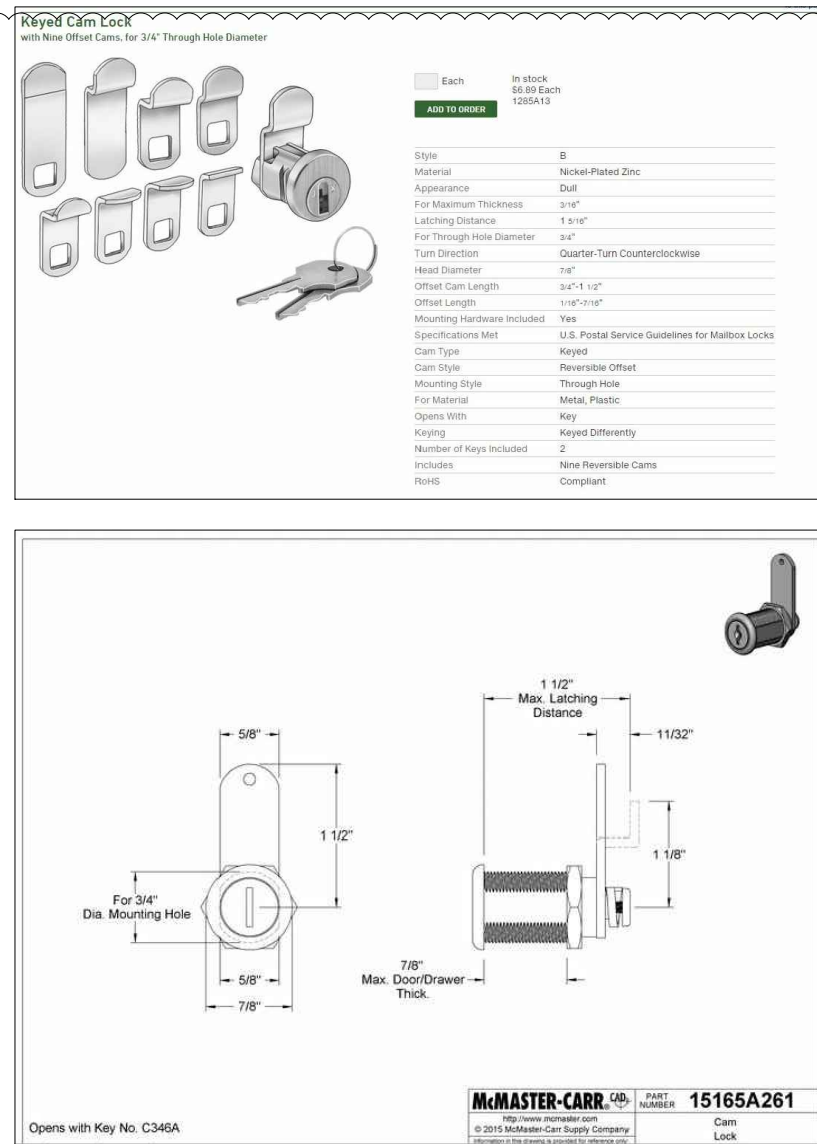

4 CAM LOCK

Scale: NTS

[illegible]