


Need more info. where is chase to? Does this meet code this way? SG should do access hatch if hardware is in an adjacent recess by GC.

NOTES:  
1. SG TO CONFIRM ALL DIMENSIONS ONCE GC COMPLETES SPACE BUILD OUT.  
2. LIGHTING HARDWARE TO BE LOCATED BY ACCESS HATCH BY GC.

FINISH CHART	
IDEN	TYPE
PT - 01	PAINT
PT - 03	PAINT

Not Finalised!  
Needs to be tested.  
See note previous submittal


1" milk acrylic  
Screwed to back of window frame

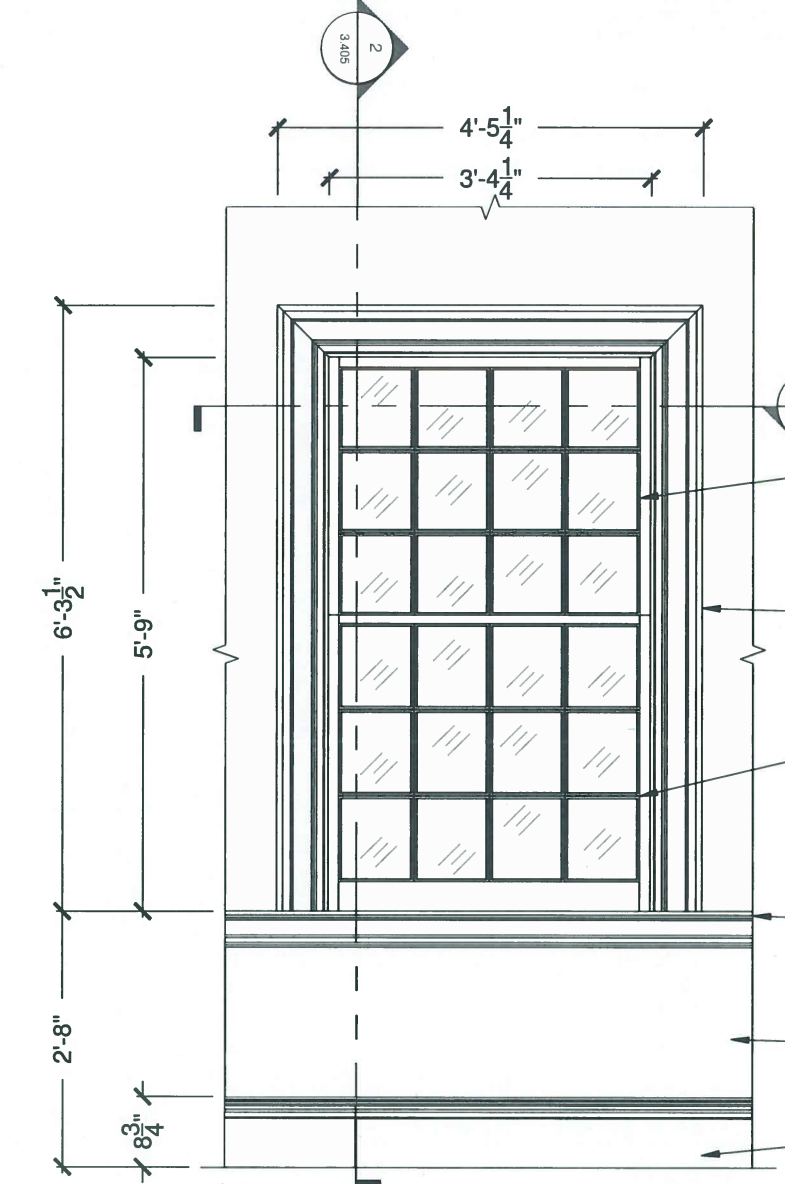

**APPROVAL**




APPROVED ☐  
APPROVED AS NOTED ☐  
NOT APPROVED ☒  
RESUBMIT DRAWING ☒  
SIGNATURE \_\_\_\_\_  
DATE 8-15-17  
Gallagher & Associates

Submittal  
Received  
2017-08-07

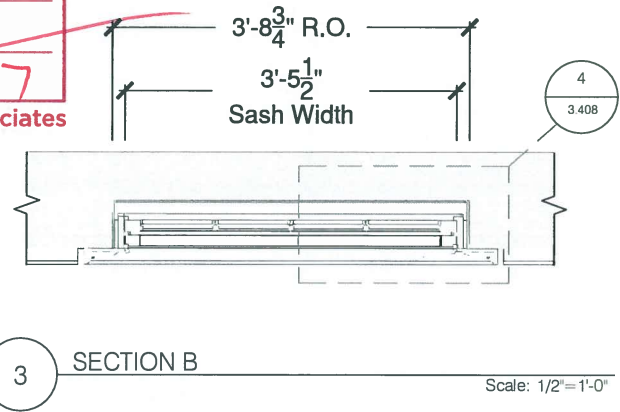

RGB LED Light Panel  
3'-7 3/4" x 6'-0 1/2"  
Lumisheet or equivalent  
Mount to blocking and screwed to existing wall

what's this?

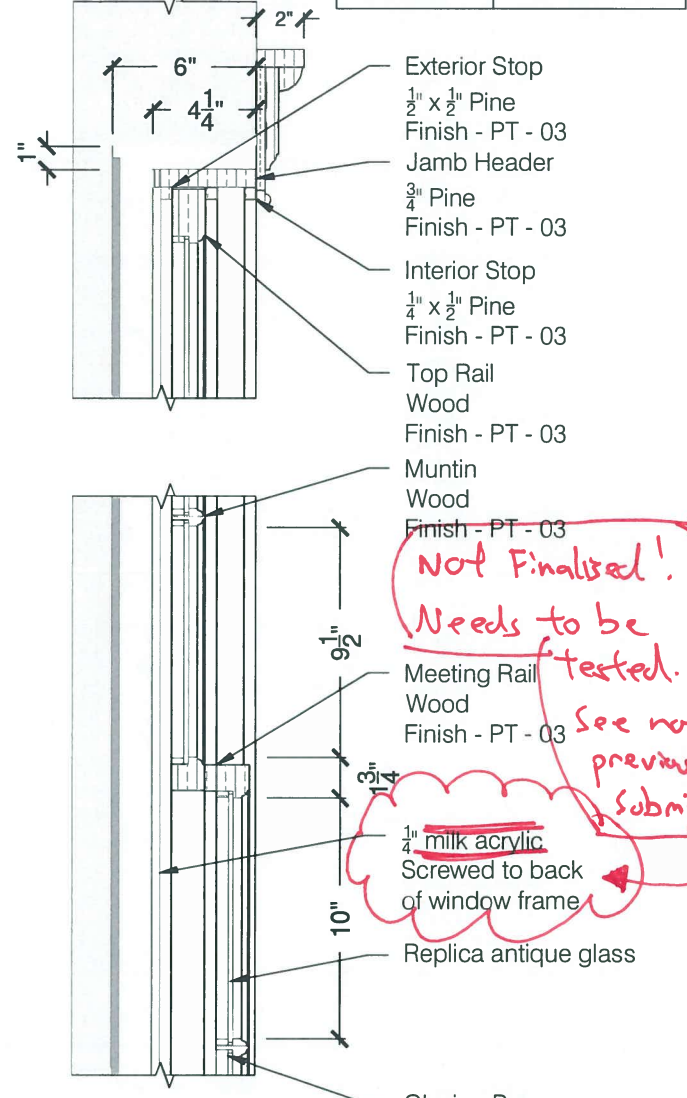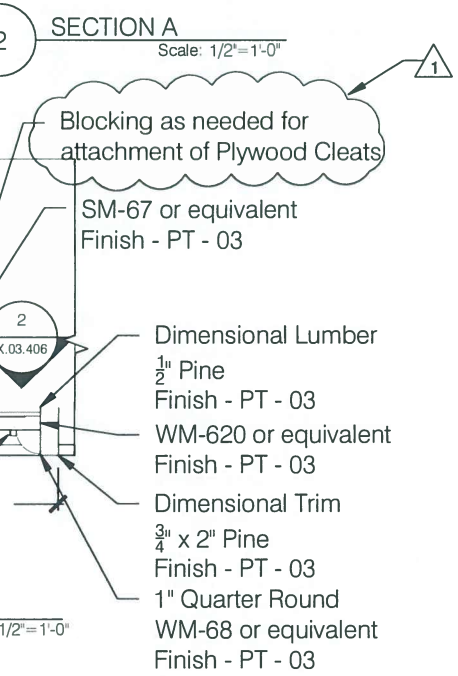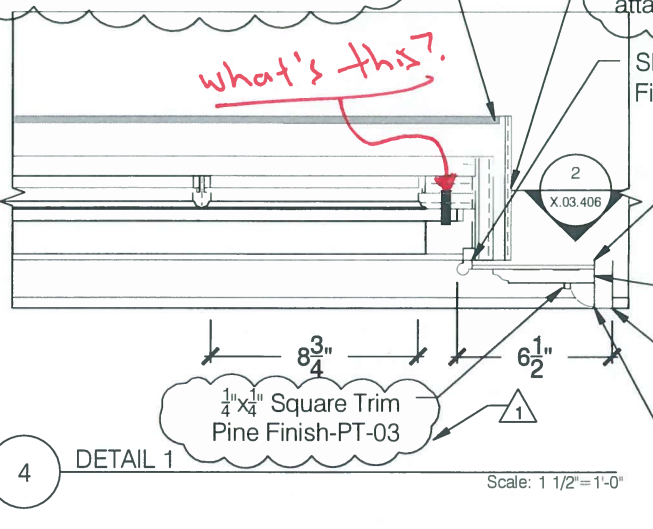

Released:	
NO:	Date
0	07/14/2017
1	08/04/2017
2	
3	
4	

Client Approval

Signature: \_\_\_\_\_ Date: \_\_\_\_\_

Review & Return ☒ For Information Only ☐

Approved ☐ Approved As Noted ☐ Revise And Resubmit ☐

PROJECT MANAGER  
WHITNEY HINES


CONTACT INFORMATION  
whitney.hines@solomongroup.com

PROJECT ADDRESS  
3200 MOUNT VERNON HWY, MT VERNON, VA 22121

SHEET TITLE  
Window Light Box Details

SG JOB #  
SG6020  
X.03.405



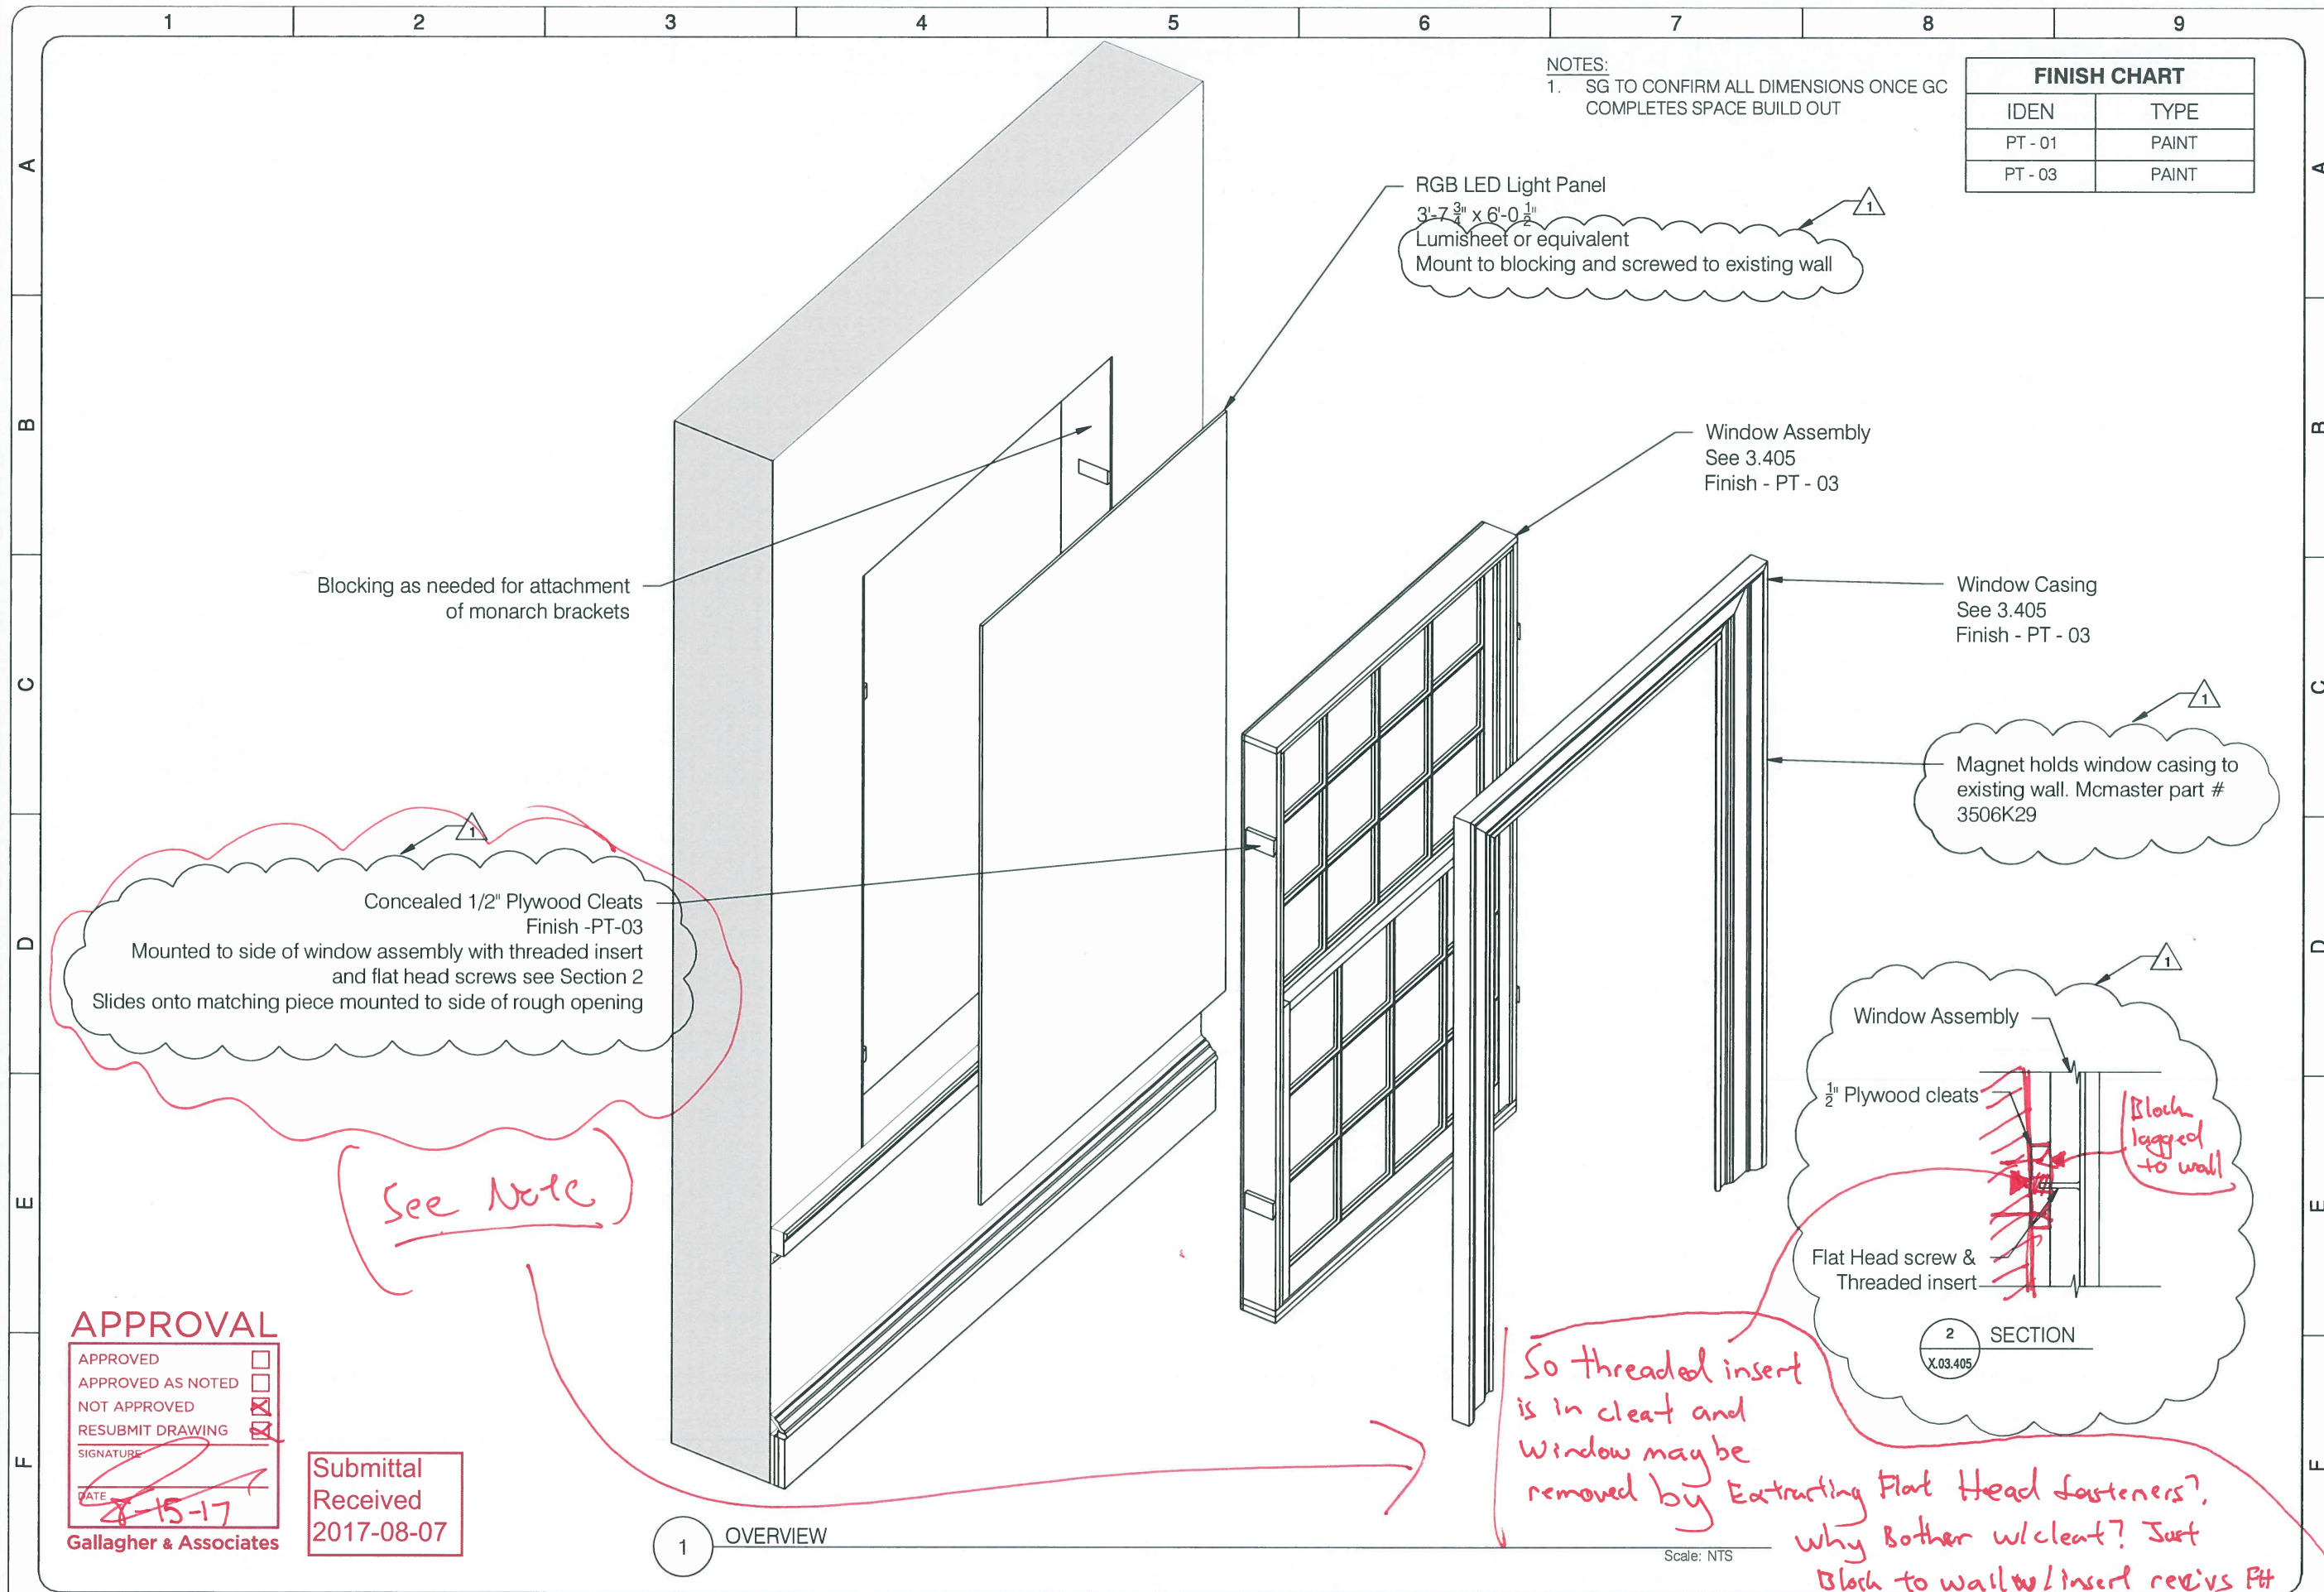

NOTES:  
1. SG TO CONFIRM ALL DIMENSIONS ONCE GC COMPLETES SPACE BUILD OUT

FINISH CHART	
IDEN	TYPE
PT - 01	PAINT
PT - 03	PAINT

Blocking as needed for attachment of monarch brackets

RGB LED Light Panel  
3'-7 3/4" x 6'-0 1/2"  
Lumisheet or equivalent  
Mount to blocking and screwed to existing wall

Window Assembly  
See 3.405  
Finish - PT - 03

Window Casing  
See 3.405  
Finish - PT - 03

Magnet holds window casing to existing wall. McMaster part # 3506K29

Concealed 1/2" Plywood Cleats  
Finish -PT-03  
Mounted to side of window assembly with threaded insert and flat head screws see Section 2  
Slides onto matching piece mounted to side of rough opening

See Note

Window Assembly  
1/2" Plywood cleats  
Flat Head screw & Threaded insert  
2 SECTION  
X.03.405

So threaded insert is in cleat and window may be removed by Extracting Flat Head fasteners? why bother w/cleat? Just Block to wall w/ insert reivs Ft fastener

**APPROVAL**  
APPROVED ☐  
APPROVED AS NOTED ☐  
NOT APPROVED ☒  
RESUBMIT DRAWING ☒  
SIGNATURE   
DATE 8-15-17  
Gallagher & Associates

Submittal  
Received  
2017-08-07

1 OVERVIEW

Scale: NTS

**solomongroup**  
THE ART OF BRINGING STORIES TO LIFE

**Released:**

NO	Date	Revisions:	Initial Release	Revised Per Redlines	Drawn By	Review By	PM	WH	MT	XX	XX
0	07/14/2017				SCH-R	MT					
1	08/04/2017				RL	MT					
2											
3											
4											

**Client Approval**

Signature: \_\_\_\_\_ Date: \_\_\_\_\_

☒ Review & Return ☐ Approved ☐ Approved As Noted ☐ Revise And Resubmit

☐ For Information Only

**PROJECT MANAGER**  
WHITNEY HINES

**CONTACT INFORMATION**  
whitney.hines@solomongroup.com

**PROJECT ADDRESS**  
3200 MOUNT VERNON HWY, MT VERNON, VA 22121

**SHEET TITLE**  
Window Light Box Overview

**PROJECT NAME**  
BE WASHINGTON

**SG JOB #**  
SG6020

**X.03.406**