



THE ART OF BRINGING STORIES TO LIFE.

825 GIROD STREET - NEW ORLEANS, LA 70130

504.252.4500 solomongroup.com

BE WASHINGTON

3200 Mount Vernon Hwy.

Mt. Vernon, VA 22121

WINDOW AND PODIUM PROTOTYPE




2.4

August 16, 2017

REVISION 2



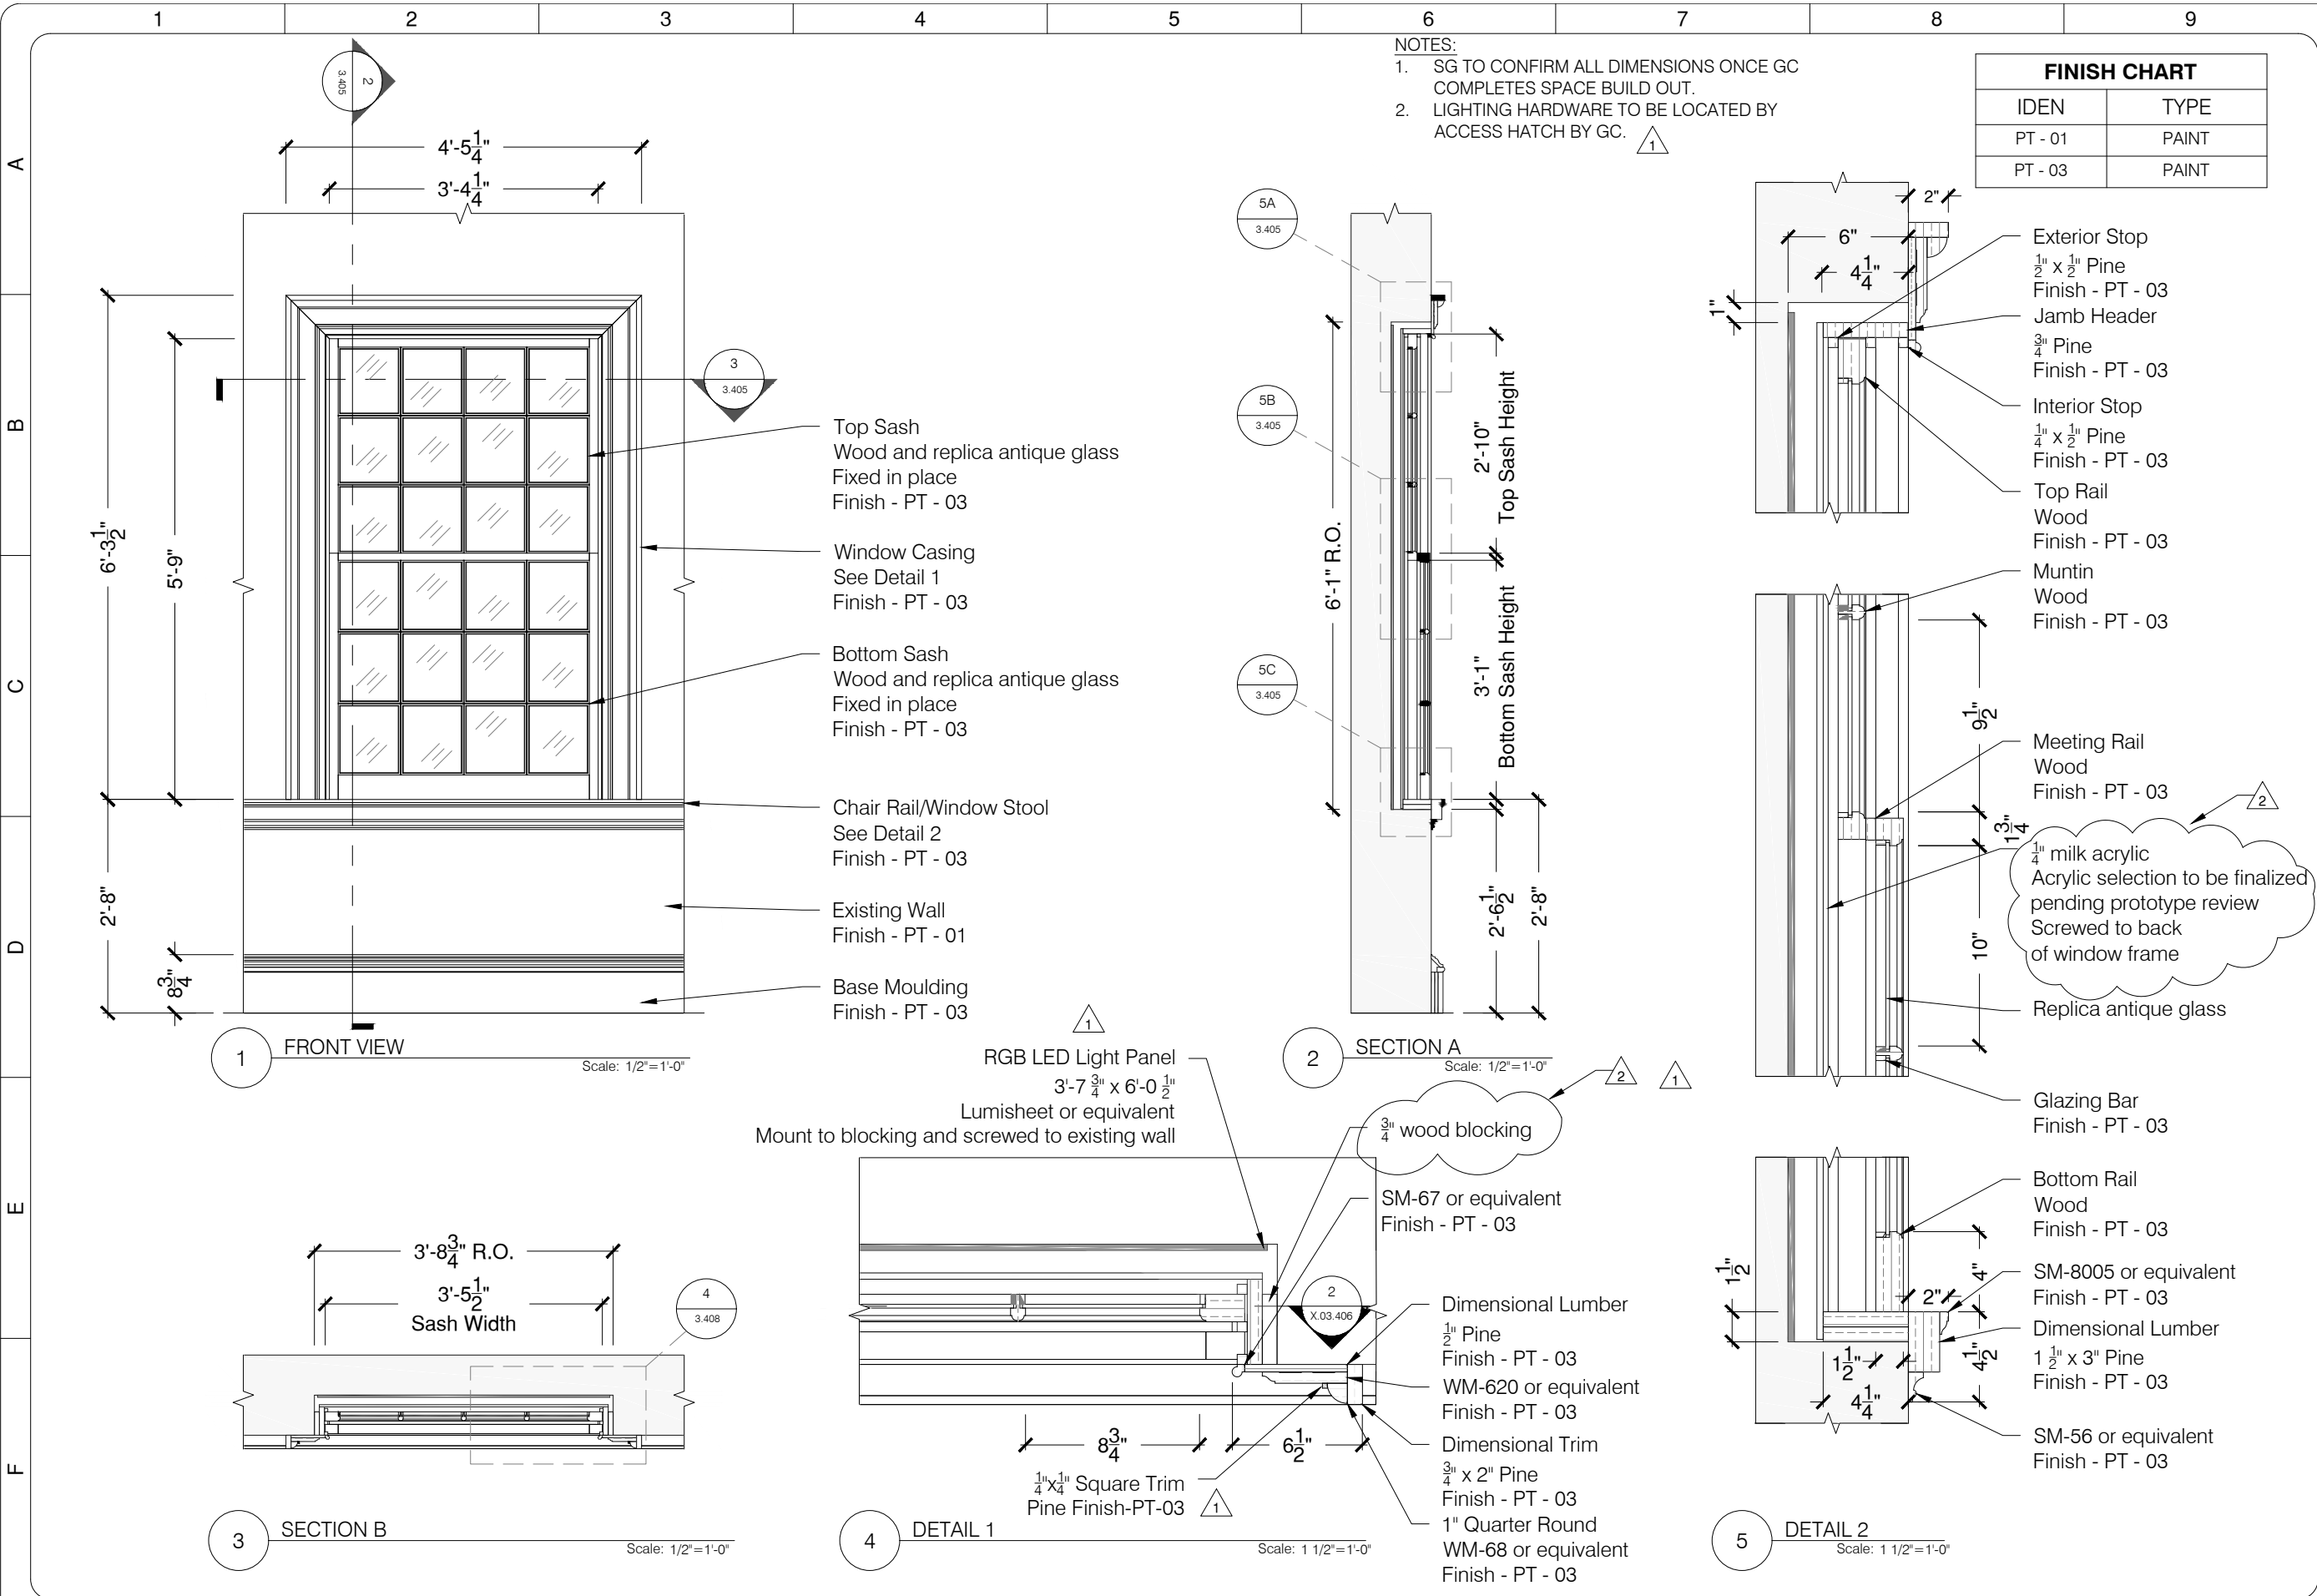

- NOTES:
- 1. SG TO CONFIRM ALL DIMENSIONS ONCE GC COMPLETES SPACE BUILD OUT.
 - 2. LIGHTING HARDWARE TO BE LOCATED BY ACCESS HATCH BY GC.

FINISH CHART	
IDEN	TYPE
PT - 01	PAINT
PT - 03	PAINT



Released:		Review By	PM
NO:	Date	Drawn By	WH
0	07/14/2017	SCHR	MT
1	08/04/2017	RL	WH
2	8/16/2017	SCHR	MT
3			XX
4			XX

Client Approval

Signature: _____ Date: _____

☒ Review & Return ☐ Approved ☐ Approved As Noted ☐ Revise And Resubmit

PROJECT MANAGER
WHITNEY HINES

CONTACT INFORMATION
whitney.hines@solomongroup.com


PROJECT NAME
BE WASHINGTON

PROJECT ADDRESS
3200 MOUNT VERNON HWY, MT VERNON, VA 22121

SHEET TITLE
Window Light Box Details

SG JOB #
SG6020

X.03.405

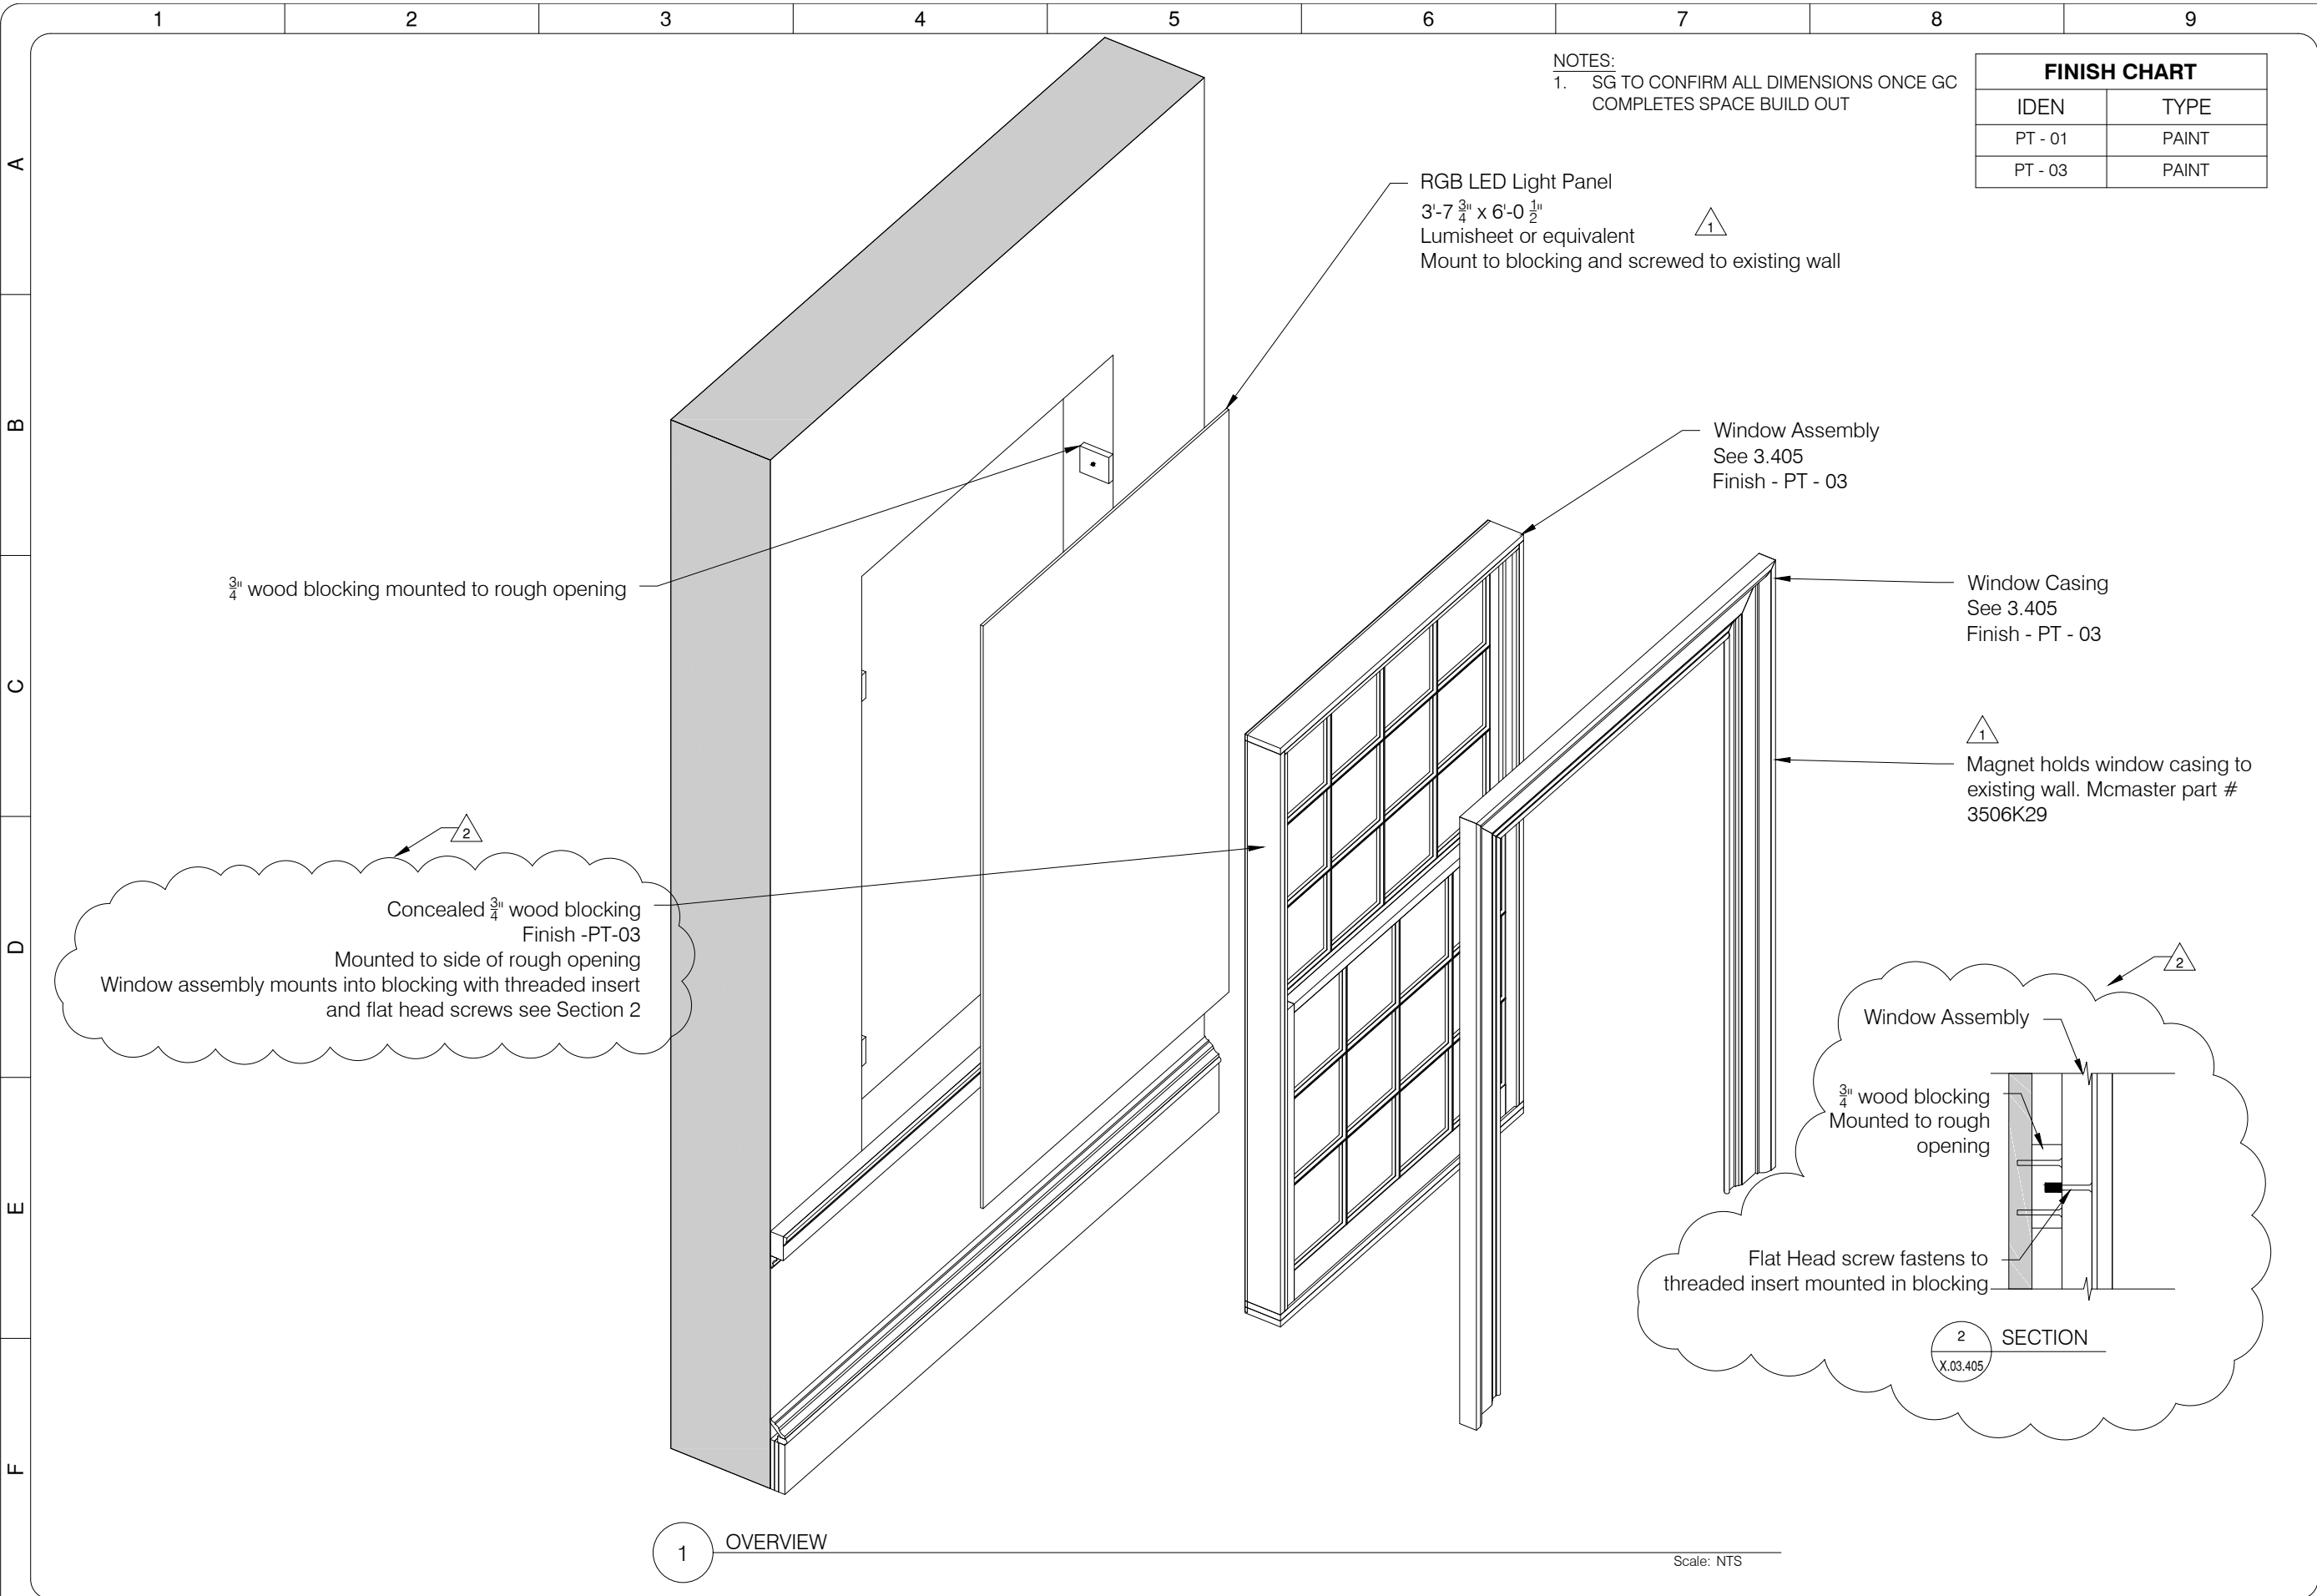

NOTES:
1. SG TO CONFIRM ALL DIMENSIONS ONCE GC COMPLETES SPACE BUILD OUT

FINISH CHART	
IDEN	TYPE
PT - 01	PAINT
PT - 03	PAINT



Released:		Review By		Drawn By		Revisions:		Date		NO:	
PM		WH		SCHR		INITIAL RELEASE		07/14/2017		0	
MT		MT		RL		REVISED PER REDLINES		08/04/2017		1	
WH		WH		SCHR		REVISED PER REDLINES		8/16/2017		2	
XX		XX								3	
										4	

Client Approval

Signature: _____ Date: _____

☒ Review & Return ☐ For Information Only

☐ Approved ☐ Approved As Noted ☐ Revise And Resubmit

PROJECT MANAGER
WHITNEY HINES

CONTACT INFORMATION
whitney.hines@solomongroup.com

STANDARD TOLERANCES
DIMENSIONS IN INCHES
FRACTIONS DECIMALS
1/8" 0.125" 0.125"
1/4" 0.250" 0.250"
3/8" 0.375" 0.375"
1/2" 0.500" 0.500"
3/4" 0.750" 0.750"
1" 1.000" 1.000"
2" 2.000" 2.000"
3" 3.000" 3.000"
4" 4.000" 4.000"
6" 6.000" 6.000"
8" 8.000" 8.000"
10" 10.000" 10.000"

PROJECT NAME
BE WASHINGTON

PROJECT ADDRESS
3200 MOUNT VERNON HWY, MT VERNON, VA 22121

SHEET TITLE
Window Light Box Overview

SG JOB #
SG6020

X.03.406

